


CORNER RECORD

Agency Index: CR-22-175

Document Number: _____

City of LATHROP County of SAN JOAQUIN, California

Brief Legal Description FOUND MONUMENT AT THE INTERSECTION OF LATHROP ROAD AND HARLAN ROAD.

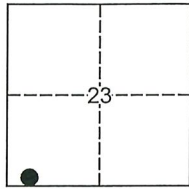

T.1S, R.6E

CORNER TYPE

- Government Corner Control
 Meander Property
 Rancho Other

Date of Survey 03-03-2022

COORDINATES (Optional)

N. _____ E. _____

Elevation _____

Units Metric U.S. Survey Foot

Horizontal Datum _____

Zone _____ Epoch Date _____

Vertical Datum _____

Complies with Public Resources Code SS8801-8819

Complies with Public Resources Code SS8890-8902

PLS Act Ref: 8765(d) 8771 8773 Other:

Corner/Monument: Left as found Established Rebuilt Pre-Construction
 Found and Tagged Reestablished Referenced Post-Construction

Narrative of corner identified and monument as found, set, reset, replaced, or removed:

See sheet #2 for description(s):

FOUND ONE (1) 2-1/2" BRASS DISK STAMPED "L.S. 6953" IN MONUMENT WELL AT THE INTERSECTION
OF LATHROP ROAD AND HARLAN ROAD AS SHOWN ON MAP FILED FOR RECORD IN BOOK 36 OF SURVEYS,
AT PAGE 9, S.J.C.R. SET FOUR (4) NAILS WITH BRASS TAG "L.S. 6953" AS WITNESS CORNERS, ALL AS
SHOWN ON PAGE 2.

SURVEYOR'S STATEMENT

This Corner Record was prepared by me or under my direction in conformance with the Land Surveyors' Act on JUNE 9, 2022,

Signed [Signature] P.L.S. or R.C.E. Number 6953



COUNTY SURVEYOR'S STATEMENT

This Corner Record was received June 10, 2022


and examined and filed June 30, 2022

Signed James E Hart P.L.S. or R.C.E. No: 8657

Title County Surveyor



County Surveyor's Comment _____

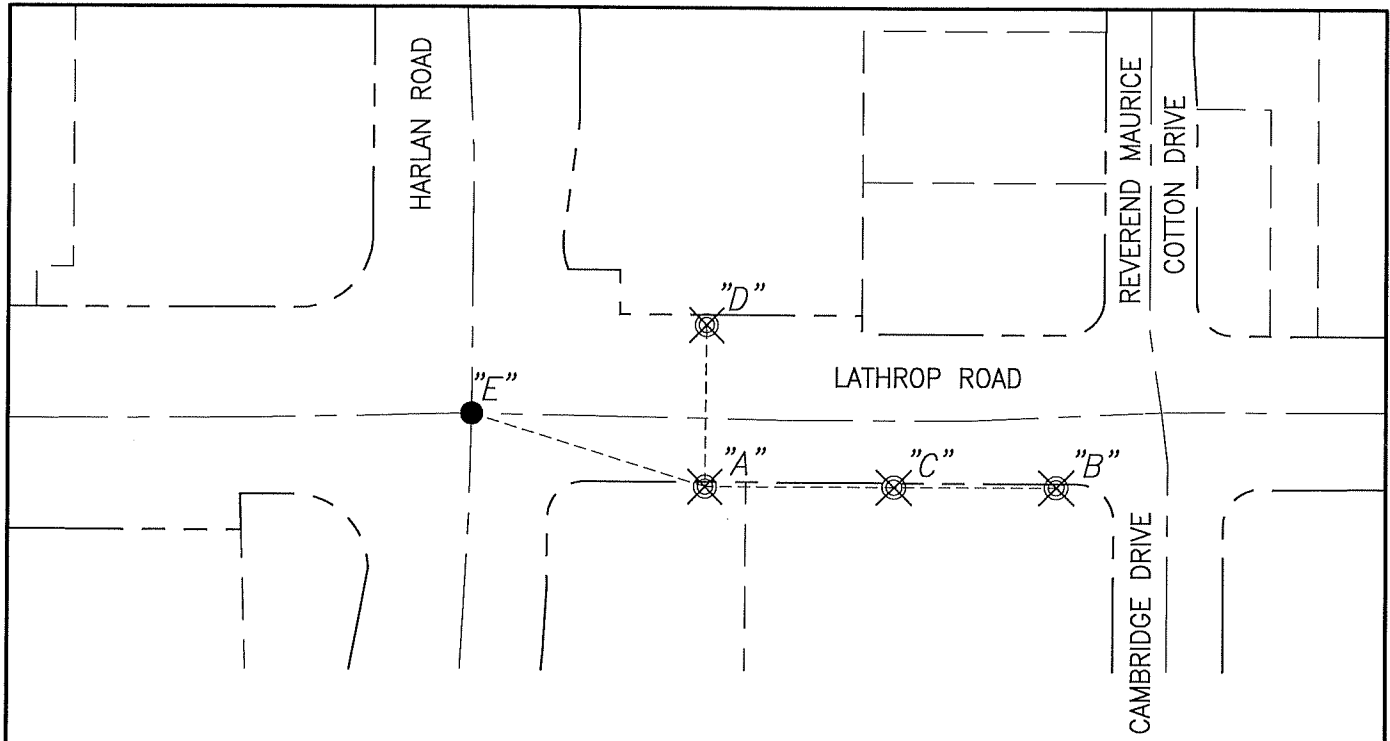

| AZ AND DISTANCE TABLE | | |
|-----------------------|------------|-------------|
| BS-@-FS | AZ | FS DISTANCE |
| B-A-B | 00°00'00" | 191.16'(M) |
| B-A-C | 00°00'00" | 102.55'(M) |
| B-A-D | 270°40'06" | 87.81'(M) |
| B-A-E | 197°13'04" | 133.12'(M) |



NOT TO SCALE

LEGEND:

- ⊗ SET NAIL WITH BRASS TAG STAMPED "L.S. 6953" IN SIDEWALK
- FOUND 2-1/2" BRASS DISK STAMPED "L.S. 6953" IN MONUMENT WELL
- S.J.C.R. SAN JOAQUIN COUNTY RECORDS
- S- SURVEYS
- (M) MEASURED DISTANCE. ALL DISTANCES ARE MEASURED UNLESS NOTED OTHERWISE.

REFERENCE:

(R1) 36-S-09, S.J.C.R.