CORNER RECORD

Document Number County of San Joaquin . California Brief Legal Description Parcels 2 & 3 (P.M. 23-198), portion of Lot 7 of "Plat of Creaner Tract" **CORNER TYPE COORDINATES (Optional)** Government Corner Control Elevation Meander Property Units Metric U.S. Survey Foot Rancho Other Horizontal Datum Zone Epoch Date Date of Survey February 11, 2022 Vertical Datum Complies with Public Resources Code §§8801-8819 Complies with Public Resources Code §§8890-8902 PLS Act Ref.: × 8765(d) 8771 8773 Other: Left as found Established Rebuilt Corner/ Pre-Construction Monument: Found and tagged Reestablished Referenced Post-Construction Narrative of corner identified and monument as found, set, reset, replaced, or removed: See sheet #2 for description(s): PRE-CONSTRUCTION CORNER RECORD. THIS DOCUMENT IS FOR THE PURPOSE OF PRESERVING AND ESTABLISHING TIES TO EXISTING MONUMENTS OF PARCELS 2 & 3. AS SHOWN ON BOOK 23 OF PARCEL MAPS, PAGE 198, SAN JOAQUIN COUNTY RECORDS. SURVEYOR'S STATEMENT This Corner Record was prepared by me or under my direction in conformance with the Professional Land Surveyors' Act on June 13, 2022 Signed P.L.S. or R.C.E. No. L.S. 7600 **COUNTY SURVEYOR'S STATEMENT** June 17, 2022 This Corner Record was received and examined and filed Signed Title No. 865

Agency Index

County Surveyor's Comment



WONG ENGINEERS, INC.

PLANNING ENGINEERING SURVEYING 4578 FEATHER RIVER DRIVE, SUITE A STOCKTON, CA 95219 (209)476-0011 PAGÉ 2 OF 2 JUNE 13, 2022

DESCRIPTION:

THIS DOCUMENT IS FOR THE PURPOSE OF PRESERVING AND ESTABLISHING TIES TO EXISTING MONUMENTS.

NOTE:

ALL BEARINGS AND DISTANCES SHOWN ARE FOR REFERENCE ONLY.

LEGEND:

B.O.B. BASIS OF BEARINGS

DOC. **DOCUMENT** FD. **FOUND**

IRON

MONUMENT MON.

P.M. PARCEL MAP, BOOK-PAGE SEARCHED, FOUND NOTHING SFN S.J.C.R. SAN JOAQUIN COUNTY RECORDS


60

1"=60

SCALE

FD. 3/4" I.PIPE TAGGED

L.S. 4479 (A)

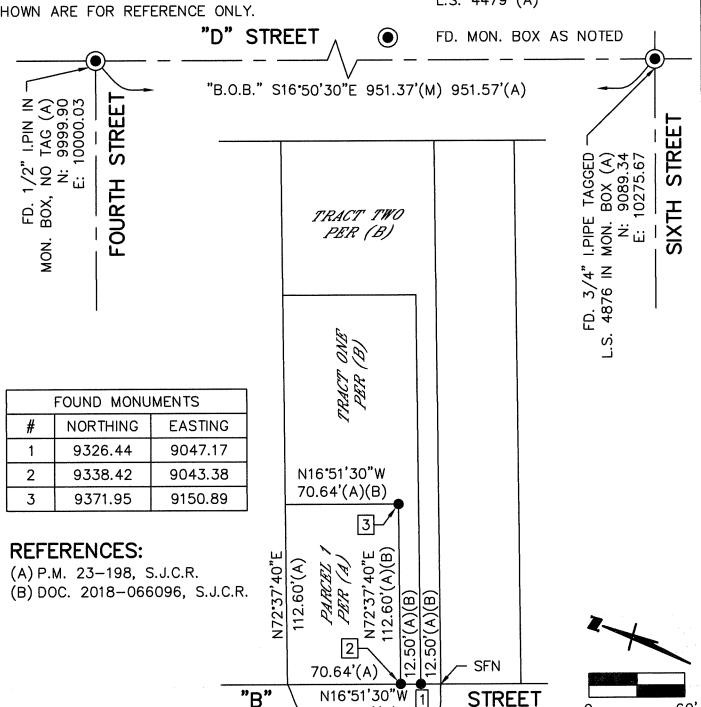

- 95.64'(A)