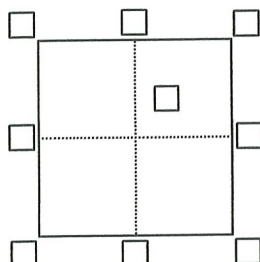


# CORNER RECORD

Agency Index

CR-22-185

Document Number

City of Stockton, County of San Joaquin, CaliforniaBrief Legal Description The centerline of Martinique Court at the east line of N. El Dorado Street per 21 M 63.**CORNER TYPE**

Government Corner ☐ Control ☒  
Meander ☐ Property ☐  
Rancho ☐ Other ☐

Date of Survey 05/22/2022**COORDINATES (Optional)**N. N/A E. N/AElevation N/AUnits ☐ Metric ☐ U.S. Survey Foot ☐Horizontal Datum N/AZone N/A Epoch Date N/AVertical Datum N/A☐ Complies with Public Resources Code §§8801-8819☐ Complies with Public Resources Code §§8890-8902

PLS Act Ref.:

☐ 8765(d)☒ 8771☐ 8773☐ OtherCorner /  
Monument:☒ Left as found☐ Established☐ Rebuilt☒ Pre-Construction☐ Found and tagged☐ Reestablished☒ Referenced☐ Post-Construction

Narrative of corner identified and monument as found, set, reset, replaced, or removed:

☐ See sheet #2 for description(s):

Found 3/4" rebar with brass tag stamped "RCE 15831 (point #6) located in a monument box on the centerline of Martinique Court at the east line of North El Dorado Street per 21 M 63. Set three (3) 1-1/4" brass discs stamped "SURVEY POINT" being drilled and then driven into the top of a concrete curb as reference points. See Page 2 of 2 for a depiction of this survey. Angles and distances established utilizing a total station.

**SURVEYOR'S STATEMENT**

This Corner Record was prepared by me or under my direction in conformance with the Professional Land Surveyors' Act on June 30, 2022

Signed

Robert W. Snow  
Robert W. Snow

P.L.S. or R.C.E. No.

8813**COUNTY SURVEYOR'S STATEMENT**

This Corner Record was received

July 8, 2022

and examined and filed

July 22, 2022

Signed

James E. Hart  
James E. Hart


P.L.S. or R.C.E. No.

8657

Title

County Surveyor

County Surveyor's Comment

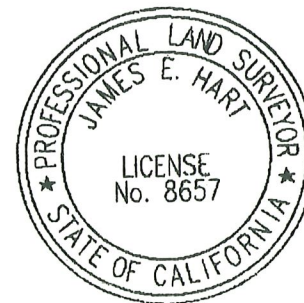

DATE: 06/30/2022

PAGE: 2 OF 6

PROJECT: ROAD DIET ON N. EL DORADO STREET, TURN AND BIKE LANES

FEDERAL PROJECT NO. HSIPL-5008(162) AND CITY PROJECT NO. WT17019

REFERENCE NOTES FOR FOUND MONUMENTS

FIELD CREW:

CITY OF STOCKTON, COUNTY OF SAN JOAQUIN

R. SNOW &amp; A. MAWLAE

FROM - TO	HZ. ANGLE	HZ. DISTANCE
103-104	00°00'00"	225.02'
103-3	∠ R = 09°03'53"	204.64'
103-105	∠ R = 15°18'06"	245.47'
103-106	∠ R = 20°36'47"	184.20'
103-107	∠ R = 149°47'10"	129.34'
103-4	∠ R = 154°43'53"	175.50'
103-108	∠ R = 164°36'53"	246.66'
103-5	∠ R = 172°07'54"	260.77'
103-109	∠ R = 172°30'14"	503.38'
103-6	∠ R = 181°40'53"	305.06'
103-110	∠ R = 179°42'34"	189.28'

- #103, #104, #105, #106, #107, #108, #109, & #110 - SET 1-1/4" BRASS DISC AS REFERENCE POINT, STAMPED "SURVEY POINT", IN TOP OF CURB
- #3 - FOUND MAG NAIL AND SHINER IN PAINTED FLIGHT X.
- #4 - FOUND 3/4" REBAR WITH BRASS TAG STAMPED "RCE 15831" LOCATED IN A MONUMENT BOX ON THE CENTERLINE OF ORLEANS COURT AT THE WEST LINE OF NORTH EL DORADO STREET PER 21 M 63
- #5 - FOUND NAIL AND WASHER, NO APPARENT STAMPING, NO APPARENT RECORD, LYING WITHIN NORTH EL DORADO STREET, JUST SOUTH OF MARTINIQUE COURT
- #6 - FOUND 3/4" REBAR WITH BRASS TAG STAMPED "RCE 15831", LOCATED IN A MONUMENT BOX ON THE CENTERLINE OF MARTINIQUE COURT AT THE EAST LINE OF NORTH EL DORADO STREET PER 21 M 63

**LEGEND:**

- FOUND NAIL AND WASHER, NO APPARENT STAMPING, NO APPARENT RECORD, POSITION UNDETERMINED
- SET 1-1/4" BRASS DISC AS REFERENCE POINT, STAMPED "SURVEY POINT"
- ◆ FOUND 3/4" REBAR WITH BRASS TAG STAMPED "RCE 15831" PER 21 M 63
- ◆ FOUND MAG NAIL AND SHINER NEAR CENTER OF STREET, IN PAINTED FLIGHT X, NO APPARENT RECORD, POSITION UNDETERMINED

BOW BACK OF WALK

EP EDGE OF PAVEMENT

M MAPS AND PLATS, S.J.C.R.

S.J.C.R. SAN JOAQUIN COUNTY RECORDS

