


CORNER RECORD

Agency Index CR-22-188
 Document Number _____

City of Stockton, County of San Joaquin, California

Brief Legal Description The end of a 1,000 foot radial arc of curve in the centerline of Ponce De Leon Avenue lying 89.31 feet (record distance) easterly of the centerline intersection of North El Dorado Street with Ponce De Leon Avenue, per 20 M 27.

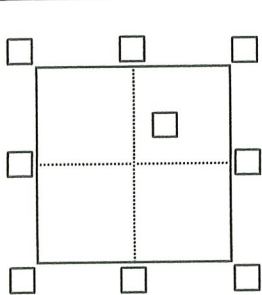

CORNER TYPE

Government Corner Control
 Meander Property
 Rancho Other
 Date of Survey 05/22/2022

COORDINATES (Optional)

N. _____ N/A _____ E. _____ N/A _____
 Elevation _____ N/A _____
 Units Metric U.S. Survey Foot
 Horizontal Datum _____ N/A _____
 Zone _____ N/A _____ Epoch Date _____ N/A _____
 Vertical Datum _____
 Complies with Public Resources Code §§8801-8819
 Complies with Public Resources Code §§8890-8902

PLS Act Ref.: 8765(d) 8771 8773 Other
 Corner / Monument: Left as found Established Rebuilt Pre-Construction
 Found and tagged Reestablished Referenced Post-Construction


Narrative of corner identified and monument as found, set, reset, replaced, or removed:
 See sheet #2 for description(s):

Found 3/4" iron pin with brass tag stamped "RCE 8189" (point #9) located in a monument box at the end of a 1,000 foot radial arc of curve in the centerline of Ponce De Leon Avenue lying 89.31 feet (record distance) easterly of the centerline intersection of North El Dorado Street with Ponce De Leon Avenue per 20 M 27. Set two (2) 1-1/4" brass discs stamped "SURVEY POINT" being drilled and then driven into the top of a concrete curb as reference points. See Page 2 of 2 for a depiction of this survey. Angles and distances established utilizing a total station.

SURVEYOR'S STATEMENT

This Corner Record was prepared by me or under my direction in conformance with the Professional Land Surveyors' Act on June 30, 2022

Signed Robert W. Snow 07-01-2022 P.L.S. or R.C.E. No. 8813
 Robert W. Snow

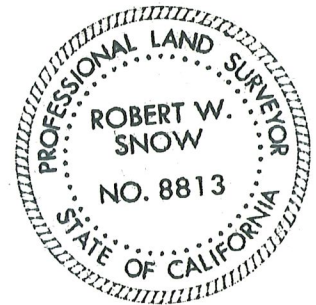

COUNTY SURVEYOR'S STATEMENT

This Corner Record was received July 8, 2022
 and examined and filed July 22, 2022

Signed James E. Hart P.L.S. or R.C.E. No. 8657
 James E. Hart

Title County Surveyor

County Surveyor's Comment



