

CORNER RECORD


Agency Index

CR-22-194

Document Number

City of Stockton, County of San Joaquin, California

Brief Legal Description The beginning of a 542 foot radial arc of curve in the centerline of North El Dorado Street lying 284.30 feet (record distance) northerly of the centerline intersection of North El Dorado Street with Los Felis Avenue, per 18 M 23.

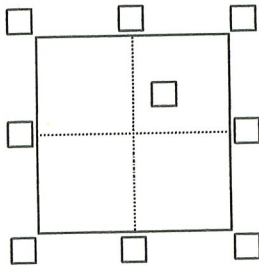CORNER TYPE**COORDINATES (Optional)**

Government Corner ☐ Control ☒
Meander ☐ Property ☐
Rancho ☐ Other ☐

Date of Survey 05/22/2022N. N/A E. N/AElevation N/AUnits ☐ Metric ☐ U.S. Survey Foot ☐Horizontal Datum N/AZone N/A Epoch Date N/A

Vertical Datum

- ☐ Complies with Public Resources Code §§8801-8819
☐ Complies with Public Resources Code §§8890-8902

PLS Act Ref.:

☐ 8765(d)☒ 8771☐ 8773☐ OtherCorner /
Monument:☒ Left as found☐ Established☐ Rebuilt☒ Pre-Construction☐ Found and tagged☐ Reestablished☒ Referenced☐ Post-Construction

Narrative of corner identified and monument as found, set, reset, replaced, or removed:
☐ See sheet #2 for description(s):

Found 3/4" iron pin, no apparent tag (point #15), located in a monument box at the beginning of a 542 foot radial arc of curve in the centerline of North El Dorado Street lying 284.30 feet (record distance) northerly of the centerline intersection of North El Dorado Street with Los Felis Avenue, per 18 M 23. Set three (3) 1-1/4" brass discs stamped "SURVEY POINT" being drilled and then driven into the top of a concrete curb as reference points. See Page 2 of 2 for a depiction of this survey. Angles and distances established utilizing a total station.

SURVEYOR'S STATEMENT

This Corner Record was prepared by me or under my direction in conformance with the Professional Land Surveyors' Act on June 30, 2022

Signed

Robert W. Snow
Robert W. Snow

P.L.S. or R.C.E. No.

8813**COUNTY SURVEYOR'S STATEMENT**

This Corner Record was received

July 8, 2022

and examined and filed

July 22, 2022

Signed

James E. Hart
James E. Hart

P.L.S. or R.C.E. No.

8657

Title

County Surveyor

County Surveyor's Comment




PROJECT: ROAD DIET ON N. EL DORADO STREET, TURN AND BIKE LANES		DATE: 06/30/2022
FEDERAL PROJECT NO. HSIPL-5008(162) AND CITY PROJECT NO. WT17019		PAGE: 5 OF 6
REFERENCE NOTES FOR FOUND MONUMENTS		FIELD CREW:
CITY OF STOCKTON, COUNTY OF SAN JOAQUIN		R. SNOW & A. MAWLAE

#116, #117, #118, #119, #120, #121, #122, #123, & #124 - SET 1-1/4" BRASS DISC AS REFERENCE POINT, STAMPED "SURVEY POINT", IN TOP OF CURB

#13, #14, #15 & #16 - FOUND 3/4" IRON PIN, NO APPARENT TAG, LOCATED IN A MONUMENT BOX ON THE CENTERLINE OF EL DORADO STREET PER 18 M 23

FROM - TO	HZ. ANGLE	HZ. DISTANCE
116-117	00°00'00"	271.14'
116-121	∠ R = 14°57'00"	89.08'
116-122	∠ R = 206°55'50"	160.08'
116-16	∠ R = 218°10'41"	177.76'
116-123	∠ R = 229°34'18"	165.88'
116-124	∠ R = 313°03'45"	71.74'
116-15	∠ R = 345°38'47"	63.83'

FROM - TO	HZ. ANGLE	HZ. DISTANCE
13-116	00°00'00"	342.17'
13-15	∠ R = 04°56'59"	284.28'
13-117	∠ R = 27°45'01"	83.40'
13-118	∠ R = 149°45'10"	56.21'
13-119	∠ R = 259°48'46"	80.16'
13-14	∠ R = 274°56'34"	62.00'
13-120	∠ R = 289°51'25"	81.66'

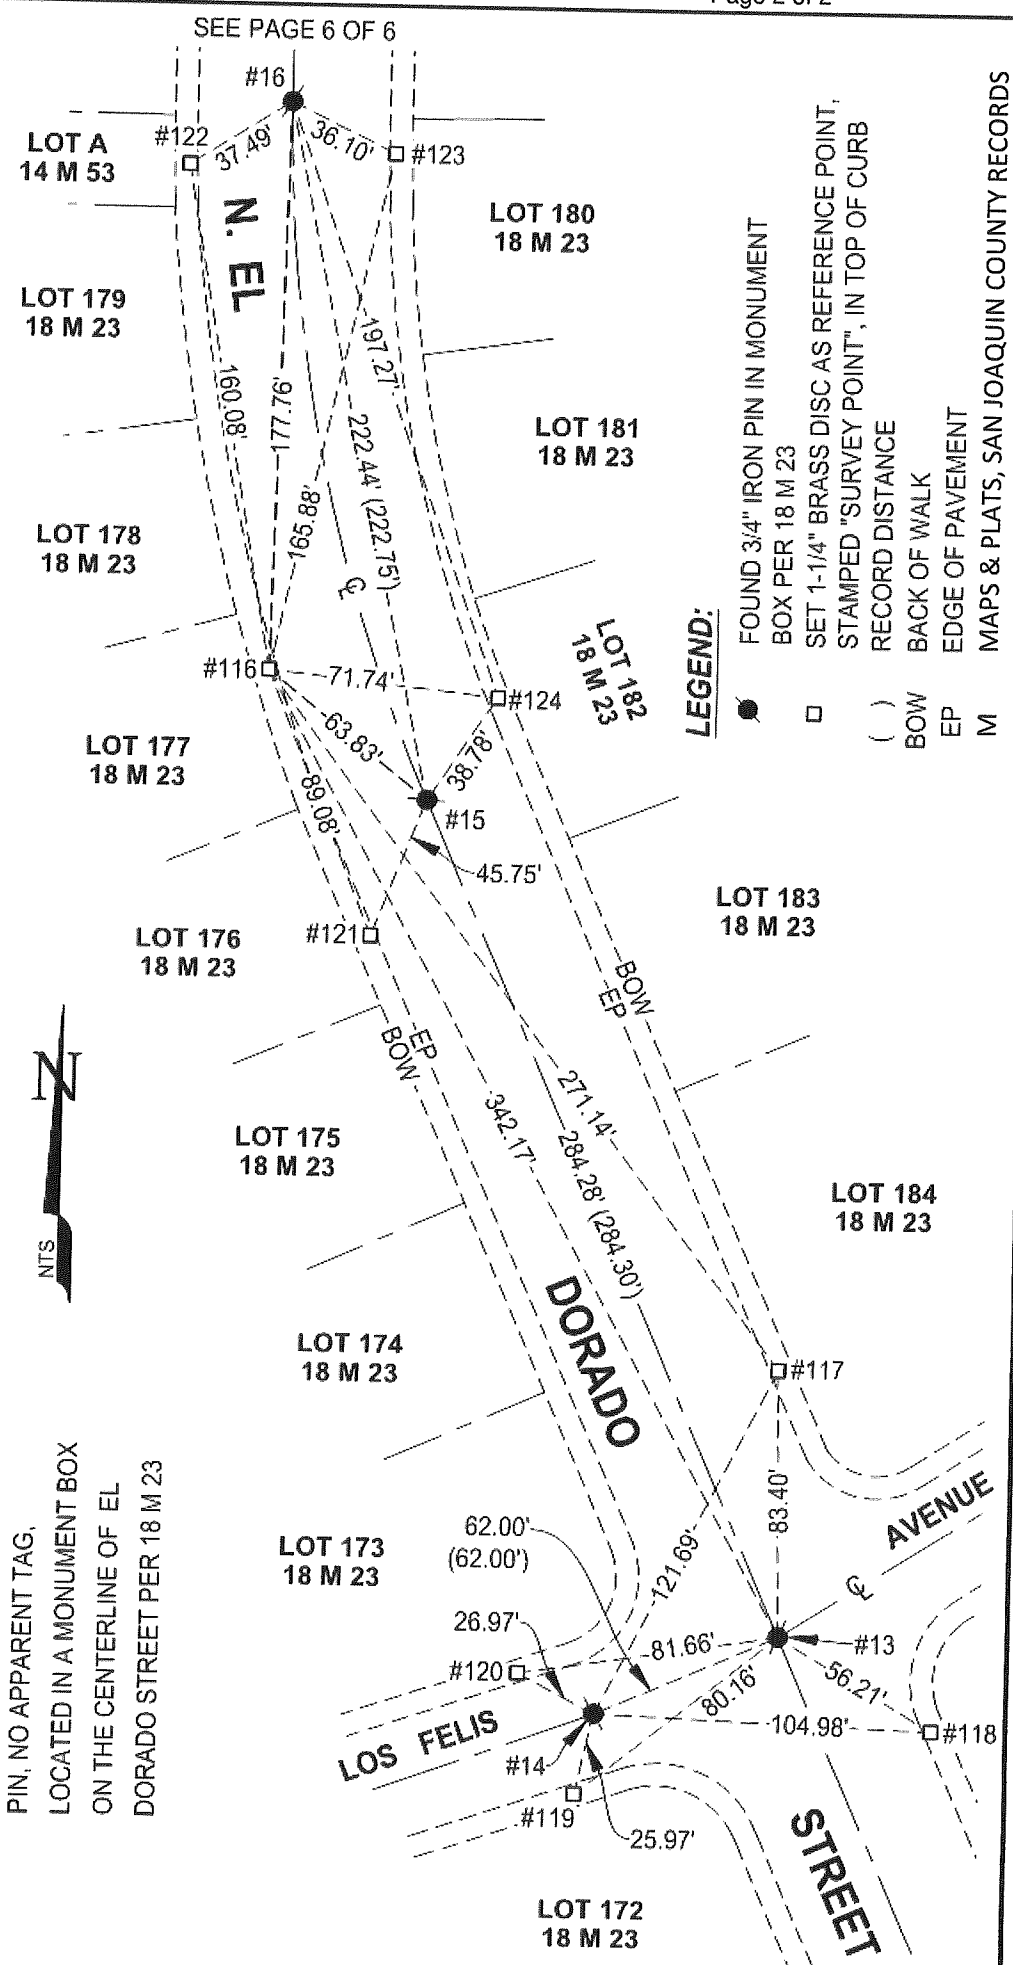

- LEGEND:**
- FOUND 3/4" IRON PIN IN MONUMENT
 - BOX PER 18 M 23
 - SET 1-1/4" BRASS DISC AS REFERENCE POINT, STAMPED "SURVEY POINT", IN TOP OF CURB
 - () RECORD DISTANCE
 - BOW BACK OF WALK
 - EP EDGE OF PAVEMENT
 - M MAPS & PLATS, SAN JOAQUIN COUNTY RECORDS