


CORNER RECORD

Agency Index CR-22-197
Document Number _____

City of STOCKTON County of SAN JOAQUIN, California
Brief Legal Description 140' NORTH OF PRODUCERS DRIVE AND INDUSTRIAL DRIVE INTERSECTION

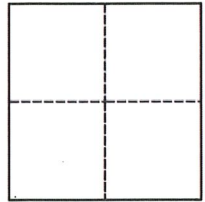

CORNER TYPE

Government Corner Control
Meander Property
Rancho Other

Date of Survey 05/10/2022

COORDINATES (Optional)

N. _____ E. _____
Elevation _____
Units Metric U.S. Survey Foot
Horizontal Datum _____
Zone _____ Epoch Date _____
Vertical Datum _____
 Complies with Public Resources Code §§8801-8819
 Complies with Public Resources Code §§8890-8902

PLS Act Ref.: 8765(d) 8771 8773 Other:
Corner/Monument: Left as found Established Rebuilt Pre-Construction
 Found and tagged Reestablished Referenced Post-Construction

Narrative of corner identified and monument as found, set, reset, replaced, or removed:
 See sheet #2 for description(s):

SEARCH BUT FOUND NOTHING APPROXIMATELY 140 FEET NORTH OF PRODUCERS DRIVE AND INDUSTRIAL DRIVE INTERSECTION AS INDICATED ON PARCEL MAP 14-144A AS SHOWN ON SHEET 2.

SURVEYOR'S STATEMENT

This Corner Record was prepared by me or under my direction in conformance with
the Professional Land Surveyors' Act on JUNE 8, 2022
Signed *James N. Landrum* P.L.S. or R.C.E. No. LS 5837




COUNTY SURVEYOR'S STATEMENT

This Corner Record was received July 15, 2022
and examined and filed August 2, 2022
Signed *James E. Hart* P.L.S. or R.C.E. No. 8657
Title County Surveyor



County Surveyor's Comment

NO SCALE

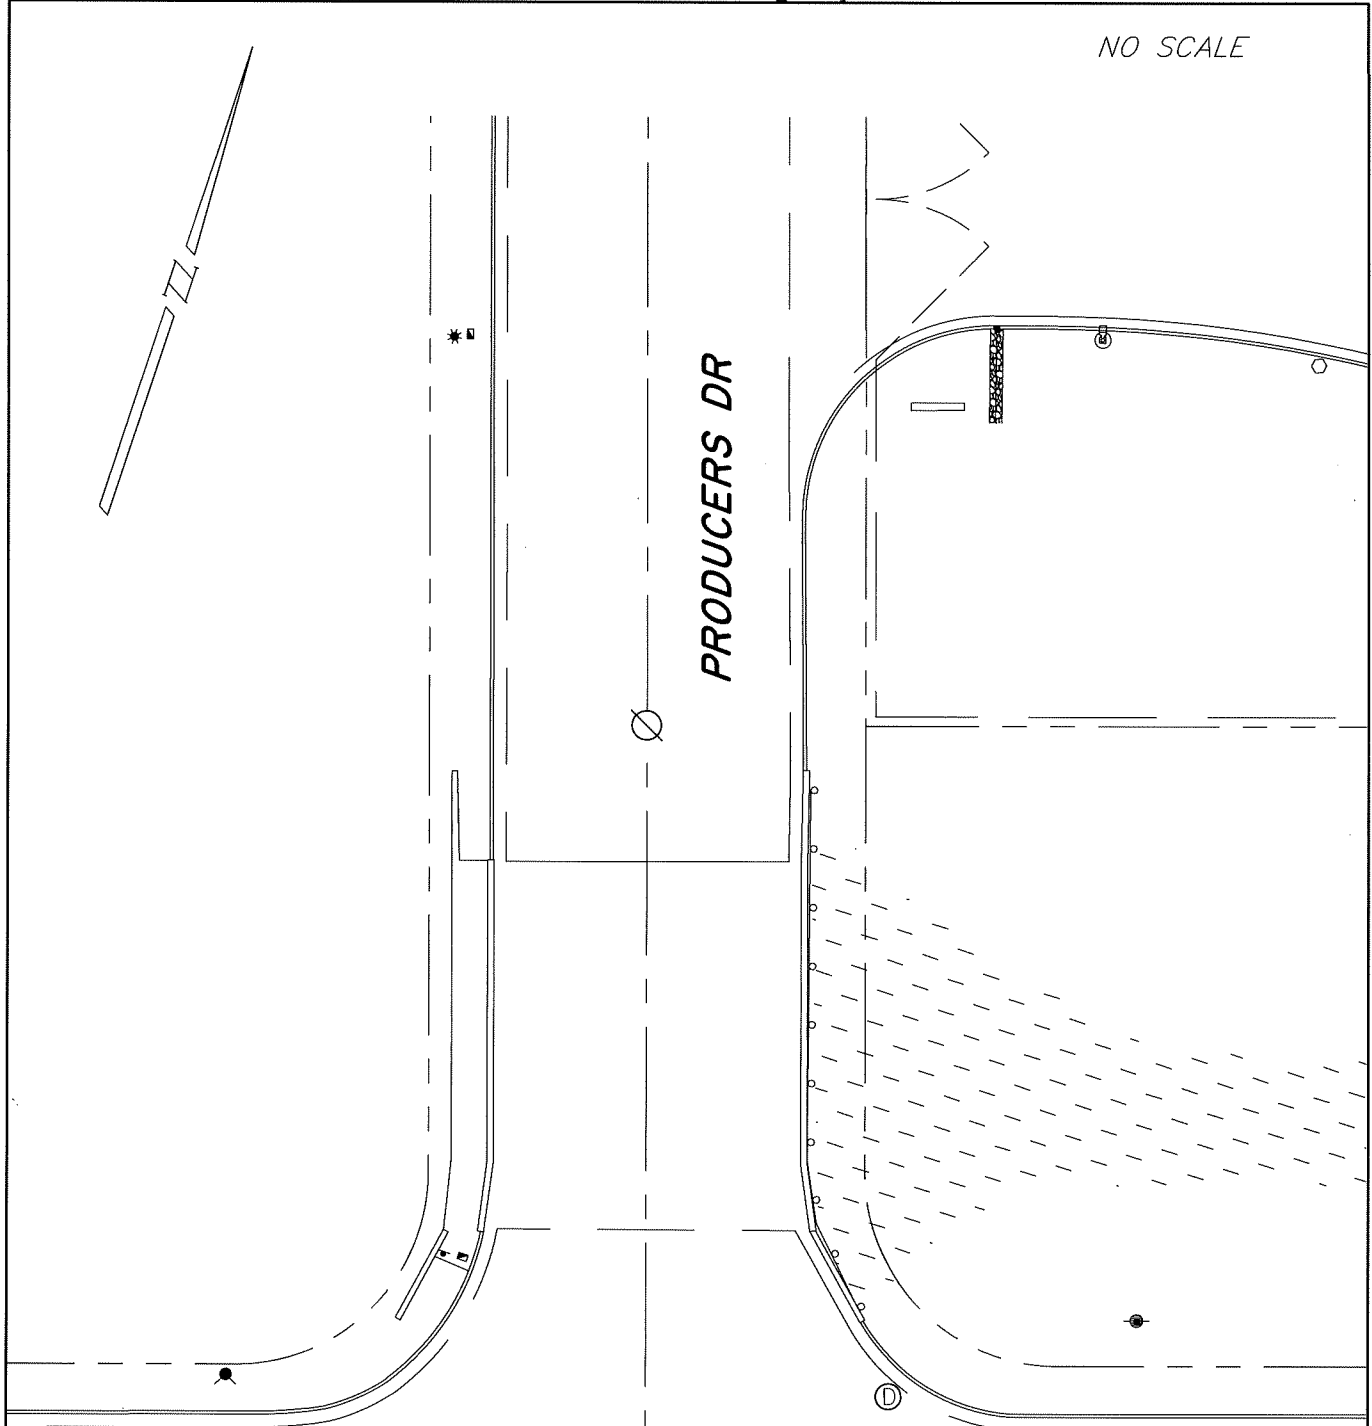

INDUSTRIAL DR

LEGEND

⊘ SEARCH NOT FOUND

NOTES

- NOTE THAT BEARINGS SHOWN ARE FOR ANGULAR CONTROL FROM LOCAL CONSTRUCTION SURVEY DATA.