

CORNER RECORD

Agency Index CR-22-208


Document Number _____

City of _____ County of SAN JOAQUIN, California

Brief Legal Description PORTIONS OF LOTS 8, 10 & 12 PER M.&P. 2-74, S.J.C.R.

CORNER TYPE

COORDINATES (Optional)

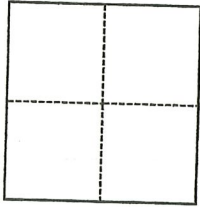

- Government Corner
- Meander
- Rancho
- Control
- Property
- Other

N. _____ E. _____
 Elevation _____
 Units Metric U.S. Survey Foot
 Horizontal Datum _____
 Zone _____ Epoch Date _____

Date of Survey June 9, 2022

- Vertical Datum _____
- Complies with Public Resources Code §§8801-8819
- Complies with Public Resources Code §§8890-8902

- PLS Act Ref.: 8765(d) 8771 8773 Other: _____
- Corner/Monument: Left as found Established Rebuilt Pre-Construction
- Found and tagged Reestablished Referenced Post-Construction

Narrative of corner identified and monument as found, set, reset, replaced, or removed:
 See sheet #2 for description(s):

SEE PAGE 2 OF 2 FOR EXHIBIT MAP SHOWING MONUMENTS FOUND AND SET

SURVEYOR'S STATEMENT

This Corner Record was prepared by me or under my direction in conformance with
 the Professional Land Surveyors' Act on 07/27/2022
 Signed Walter John Shoup P.L.S. or R.C.E. No. L-7736




COUNTY SURVEYOR'S STATEMENT

This Corner Record was received July 27, 2022
 and examined and filed August 11, 2022
 Signed James E. Hart P.L.S. or R.C.E. No. 8657
 Title County Surveyor



County Surveyor's Comment

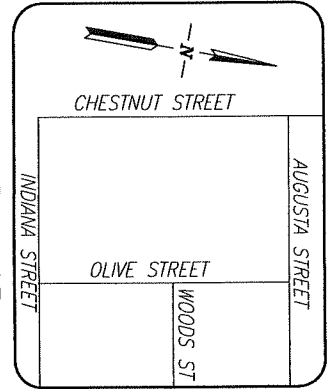

NO SCALE

LEGEND:

- C.R. CORNER RECORD, S.J.C.R.
- COR. CORNER
- D.N. DOCUMENT NUMBER, S.J.C.R.
- FD. FOUND
- MON. MONUMENT
- P.M. PARCEL MAP, BOOK-PAGE, S.J.C.R.
- S.J.C.R. SAN JOAQUIN COUNTY RECORDS
- M.&P. MAPS AND PLATS, BOOK-PAGE, S.J.C.R.


MONUMENTS FOUND & SET:

- FD. 3/4" REBAR TAGGED "L.S. 4124" PER (R1)
- ✕— FD. 3/4" REBAR PER (R1), NO TAG, SET CAP STAMPED "P.L.S. 7736"
- FD. MON. IN WELL AS DESCRIBED AND REFERENCED
- FD. 3/4" REBAR TAGGED LS 2273, NOT REFERENCED

REFERENCES

- (R1) P.M. 25-71, S.J.C.R.
- (R2) P.M. 21-51, S.J.C.R.

NOTE:
1) ALL RECORDS ARE SAN JOAQUIN COUNTY RECORDS AND BOOK OR VOLUME PRECEDES PAGE, OR AS NOTED AND REFERENCED.

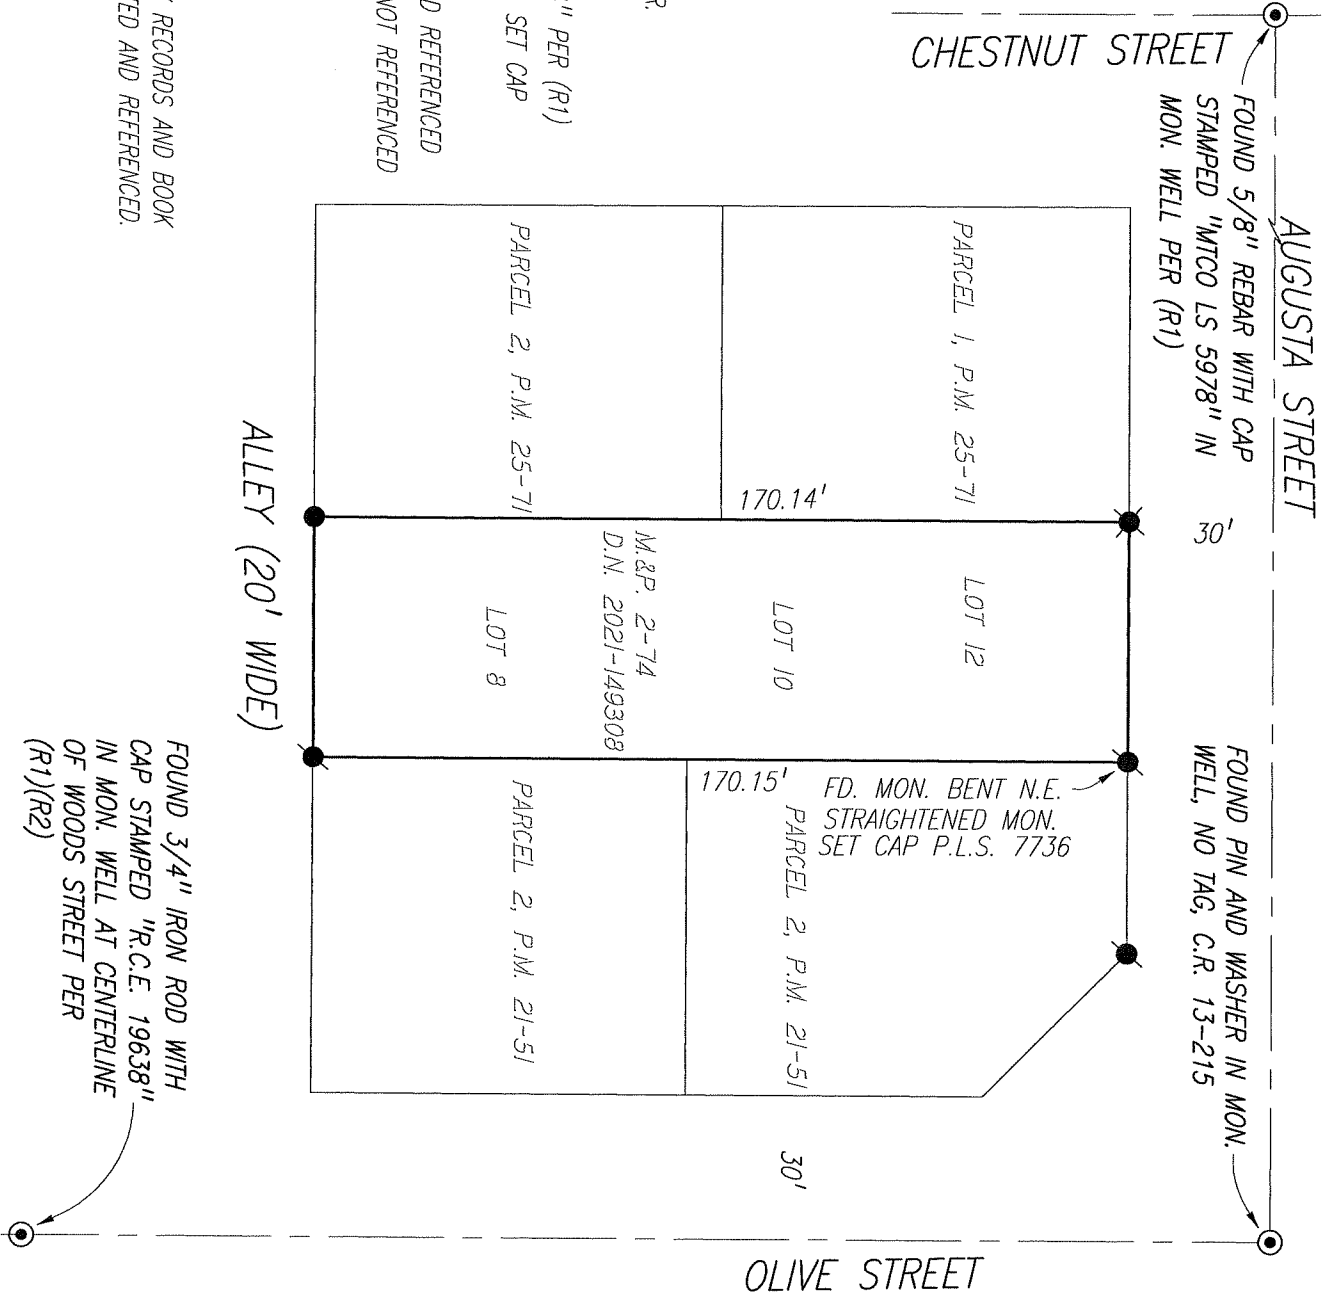

Scale: 1"=40'	CORNER RECORD EXHIBIT MAP	Date: 06/10/2022
Job No.: 22-126		DWG: 22126SV.DWG