
CORNER RECORD

Agency Index <u>CR-72-247</u> Document Number _____ City of _____ Lodi County of ____ San Joaquin Brief Legal Description Property monuments at 2543 Ivory Ln. (M&P 39-65) **CORNER TYPE** COORDINATES (Optional) N. Government Corner Control Elevation X U.S. Survey Foot X Property Meander Units Metric Rancho Other Horizontal Datum Zone Epoch Date Date of Survey June 10, 2022 Vertical Datum Complies with Public Resources Code §§8801-8819 Complies with Public Resources Code §§8890-8902 Section 15, T.3N., R.6E., M.D.B.&M. **X** 8771 8773 Other: PLS Act Ref.: 8765(d) Left as found Pre-Construction Established Rebuilt Corner/ Monument: Found and tagged Reestablished Referenced X Post-Construction Narrative of corner identified and monument as found, set, reset, replaced, or removed: See sheet #2 for description(s): USING EXISTING CENTERLINE MONUMENTS (M&P 39-65), RESET MONUMENT DESTROYED BY CONSTRUCTION WITH ONE (1) CHISELED CROSS WITH NAIL AND WASHER STAMPED "C.O.L. LS 9478" ON LOT LINE EXTENSION (NO RECORD) AT THE SAME LOCATION THE CHISELED CROSS (M&P 39-65) WAS ESTABLISHED PRIOR TO CONSTRUCTION. NO BOUNDARY ANALYSIS WAS PERFORMED. SURVEYOR'S STATEMENT This Corner Record was prepared by me or under my direction in conformance with the Professional Land Surveyors' Act on 9/14/22 Signed **COUNTY SURVEYOR'S STATEMENT** October 3, 2022. This Corner Record was received and examined and filed Signed Title **County Surveyor's Comment**

Page 1 of 2 **BPFI SG-2016**

DISTANCE (M) TABLE					
	FD MONUMENT	FROM	DISTANCE	FROM2	DISTANCE2
"A"	SET CHISELED "X" AND N&W	"B"	115.17'	"C"	139.21'

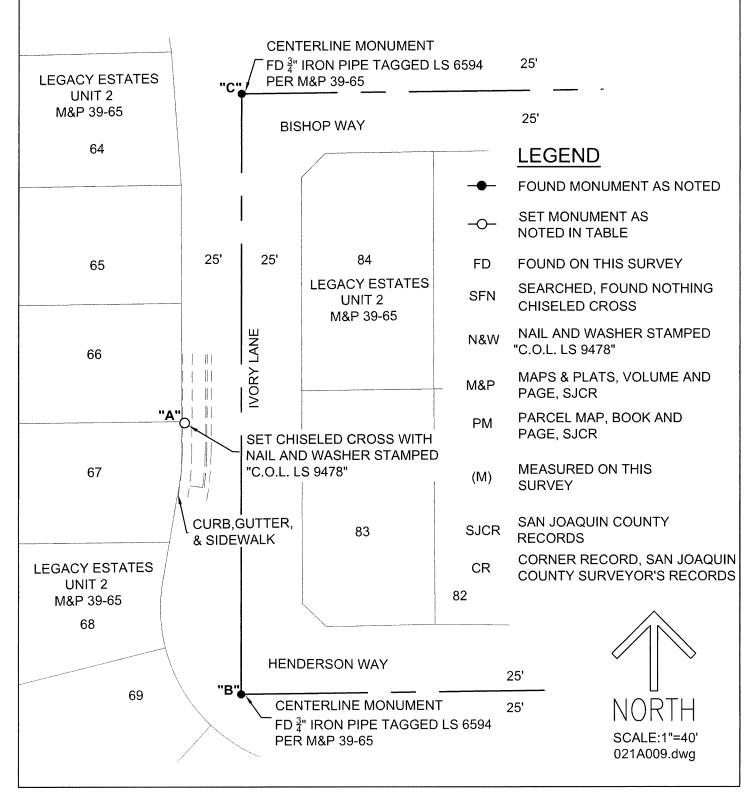

BPELSG-2016 PAGE 2 OF 2