
CORNER RECORD

Agency Index CR-22-248 Document Number Lodi County of San Joaquin , California City of Brief Legal Description Survey monument at School St./South of Chestnut St. (RS 37-1) **COORDINATES (Optional) CORNER TYPE** N. Government Corner Control Elevation 2 U.S. Survey Foot Meander X Property Units Metric Rancho Other Horizontal Datum 11 12 Zone Epoch Date Date of Survey June 17, 2022 Vertical Datum Complies with Public Resources Code §§8801-8819 Section 12, T.3N., R.6E. Complies with Public Resources Code §§8890-8902 M.D.B.&M. 8771 8773 PLS Act Ref.: 8765(d) Other: Left as found Established Rebuilt Pre-Construction Corner/ Monument: Found and tagged Referenced X Post-Construction Reestablished Narrative of corner identified and monument as found, set, reset, replaced, or removed: See sheet #2 for description(s): FOUND NAIL & SHINER TAGGED L.S. 8080 AT APPROXIMATE LOT LINE PROJECTIONS. NO RECORD MAP WAS FOUND. FOUND ONE (1) AXLE PER RS 36-88 AND ONE (1) NAIL AND WASHER STAMPED "C.O.L. LS 9478" PER CR 21-238. NO BOUNDARY ANALYSIS WAS PERFORMED. SURVEYOR'S STATEMENT This Corner Record was prepared by me or under my direction in conformance with NO. 9478 the Professional Land Surveyors' Act on Signed **COUNTY SURVEYOR'S STATEMENT** This Corner Record was received and examined and filed Signed Title **County Surveyor's Comment**

BPELSG-2016 Page 1 of 2

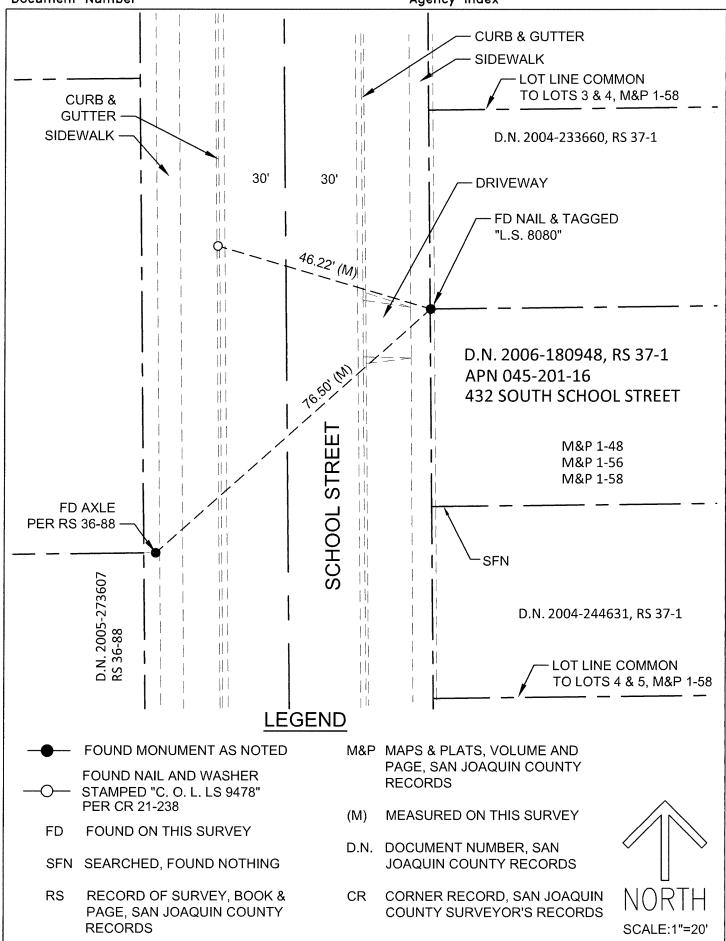

021A006.DWG