

# CORNER RECORD

Agency Index: CR-22-259

Document Number: \_\_\_\_\_

City of STOCKTON

County of SAN JOAQUIN, California

Brief Legal Description MONUMENTS AT THE INTERSECTION OF EAST FREMONT STREET AND NORTH HUNTER STREET.



CAMPO DE LOS FRANCESES

### CORNER TYPE

- Government Corner
- Meander
- Rancho
- Control
- Property
- Other

Date of Survey 8-31-2022

### COORDINATES (Optional)

- N. \_\_\_\_\_ E. \_\_\_\_\_
- Elevation \_\_\_\_\_
- Units  Metric  U.S. Survey Foot
- Horizontal Datum \_\_\_\_\_
- Zone \_\_\_\_\_ Epoch Date \_\_\_\_\_
- Vertical Datum \_\_\_\_\_
- Complies with Public Resources Code §§8801-8819
- Complies with Public Resources Code §§8890-8902

PLS Act Ref:  8765(d)  8771  8773  Other:

Corner/Monument:  Left as found  Established  Rebuilt  Pre-Construction  
 Found and Tagged  Reestablished  Referenced  Post-Construction

Narrative of corner identified and monument as found, set, reset, replaced, or removed:  
 See sheet #2 for description(s):  
**FOUND FOUR (4) NAILS WITH BRASS TAG STAMPED "L.S. 6953" AS SHOWN ON CORNER RECORD NO. 22-071, S.J.C.S.R. SET FOUR (4) NAILS WITH BRASS TAG STAMPED "L.S. 6953" AT THE NORTHWEST CORNER OF THE INTERSECTION OF EAST FREMONT STREET AND NORTH HUNTER STREET, ALL AS SHOWN ON PAGE 2.**

### SURVEYOR'S STATEMENT

This Corner Record was prepared by me or under my direction in conformance with the Land Surveyors' Act on SEPTEMBER 15, 2022,



Signed [Signature] P.L.S. or R.C.E. Number 6953


### COUNTY SURVEYOR'S STATEMENT

This Corner Record was received October 18, 2022 and examined and filed October 27, 2022

Signed James E. Hart P.L.S. or R.C.E. No: 8657  
Title County Surveyor



County Surveyor's Comment \_\_\_\_\_

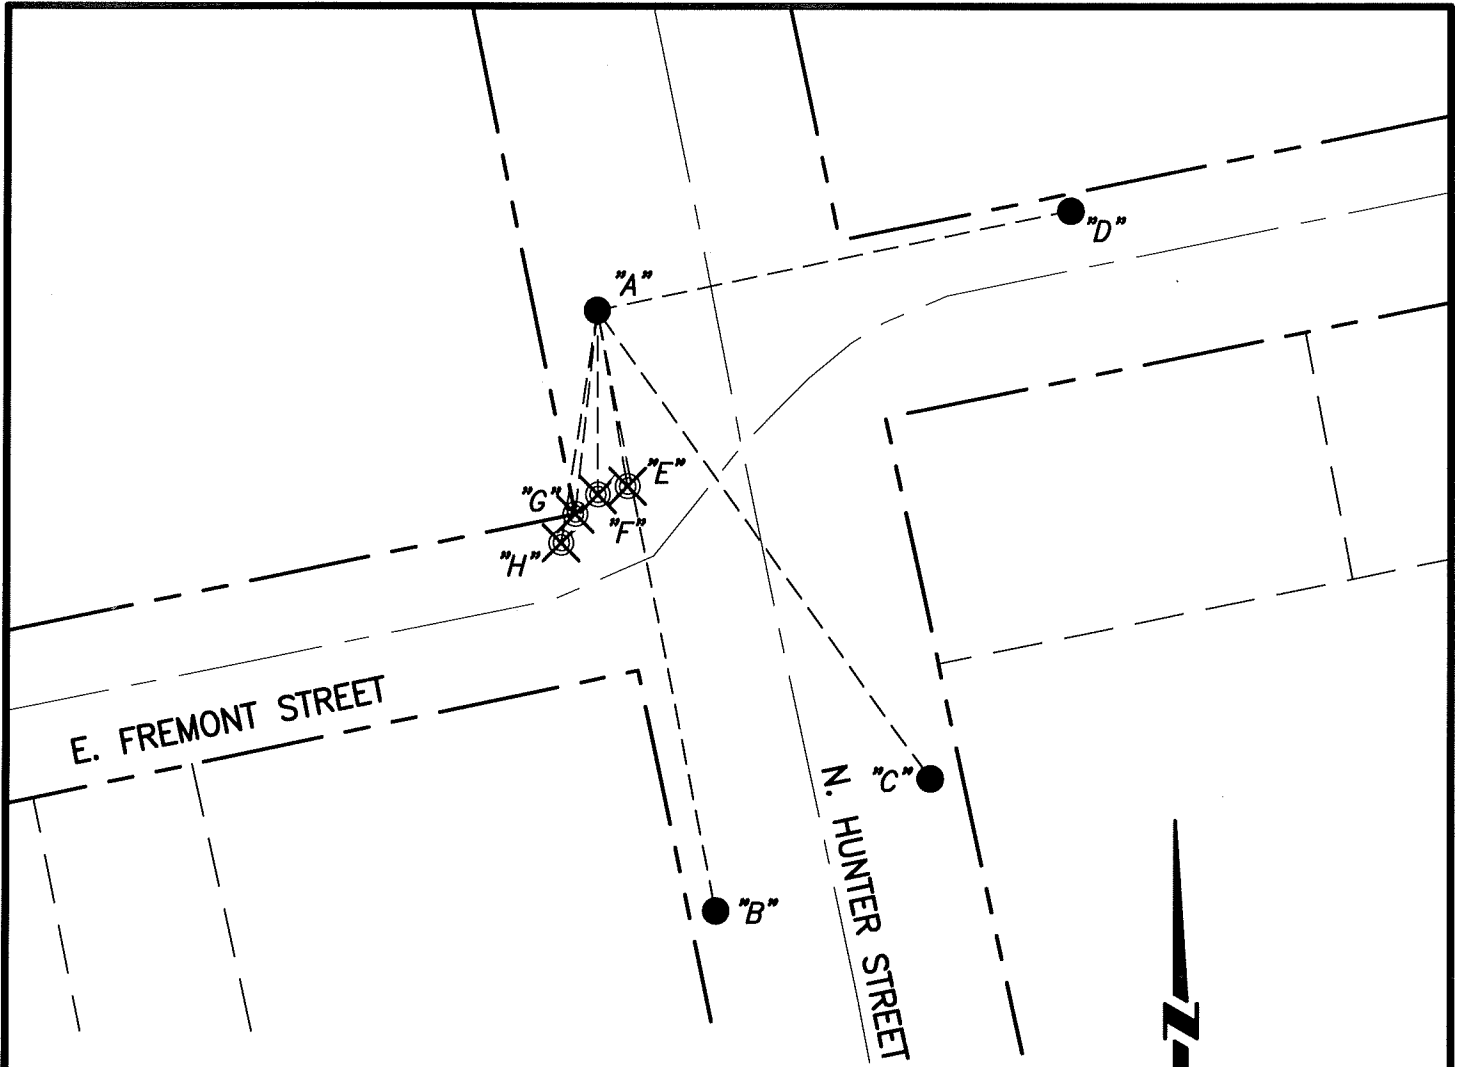

Bearing and Distance Table		
BS-@-FS	Bearing	FS Distance
B-A-B	00°00'00"	140.93'(M)(R1)
B-A-C	337°58'23"	132.16'(M)(R1)
B-A-D	269°40'04"	112.17'(M)(R1)
B-A-E	6°50'26"	37.76'(M)(R1)
B-A-F	9°47'20"	38.17'(M)(R1)
B-A-G	20°56'55"	40.48'(M)(R1)
B-A-H	18°36'09"	48.34'(M)(R1)

**LEGEND:**

- FOUND NAIL WITH BRASS TAG STAMPED "L.S. 6953" (R1)
- ⊗ SET NAIL WITH BRASS TAG STAMPED "L.S. 6953"

S.J.C.S.R. SAN JOAQUIN COUNTY SURVEYOR'S RECORDS

(M) MEASURED DISTANCE. ALL DISTANCES ARE MEASURED UNLESS NOTED OTHERWISE.

C.R. CORNER RECORD

**REFERENCE:**

(R1) C.R.-22-071, S.J.C.S.R.