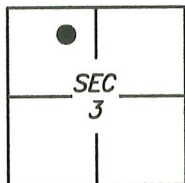


# CORNER RECORD

Agency Index CR-22-299

Document Number \_\_\_\_\_

City of \_\_\_\_\_

County of SAN JOAQUIN, CaliforniaBrief Legal Description FOUND MONUMENT ON SOUTH TUXEDO AVENUE NEAR APN 113-070-56, S.J.C.R.  
NO MAPS AVAILABLE.

T1N/R6E

## CORNER TYPE

Government Corner	<input type="checkbox"/>	Control	<input type="checkbox"/>
Meander	<input type="checkbox"/>	Property	<input checked="" type="checkbox"/>
Rancho	<input type="checkbox"/>	Other	<input type="checkbox"/>

Date of Survey 2021/04/28

## COORDINATES (Optional)

N. \_\_\_\_\_ E. \_\_\_\_\_

Elevation \_\_\_\_\_

Units Metric ☐ U.S. Survey Foot ☐

Horizontal Datum \_\_\_\_\_

Zone \_\_\_\_\_ Epoch Date \_\_\_\_\_

Vertical Datum: \_\_\_\_\_

☐ Complies with Public Resources Code §§8801-8819☐ Complies with Public Resources Code §§8890-8902PLS Act Ref.: ☐ 8765(d) ☒ 8771 ☐ 8773

Other: \_\_\_\_\_

Corner/ Monument:	<input type="checkbox"/> Left as found	<input type="checkbox"/> Established	<input type="checkbox"/> Rebuilt	<input checked="" type="checkbox"/> Pre-Construction
	<input type="checkbox"/> Found and tagged	<input type="checkbox"/> Reestablished	<input type="checkbox"/> Referenced	<input type="checkbox"/> Post-Construction

Narrative of corner identified and monument as found and set or reset:

☒ See sheet #2 for description(s):


## SURVEYOR'S STATEMENT

This Corner Record was prepared by me or under my direction in conformance with  
the Professional Land Surveyor's Act on 16 SEPTEMBER, 2021.  
Signed [Signature] P.L.S. or R.C.E. No.: 8489




## COUNTY SURVEYOR'S STATEMENT

This Corner Record was received August 12, 2022  
and examined and filed September 1, 2022  
Signed James E. Hart P.L.S. or R.C.E. No.: 8657  
Title County Surveyor

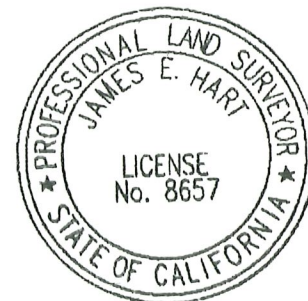

County Surveyor's Comment

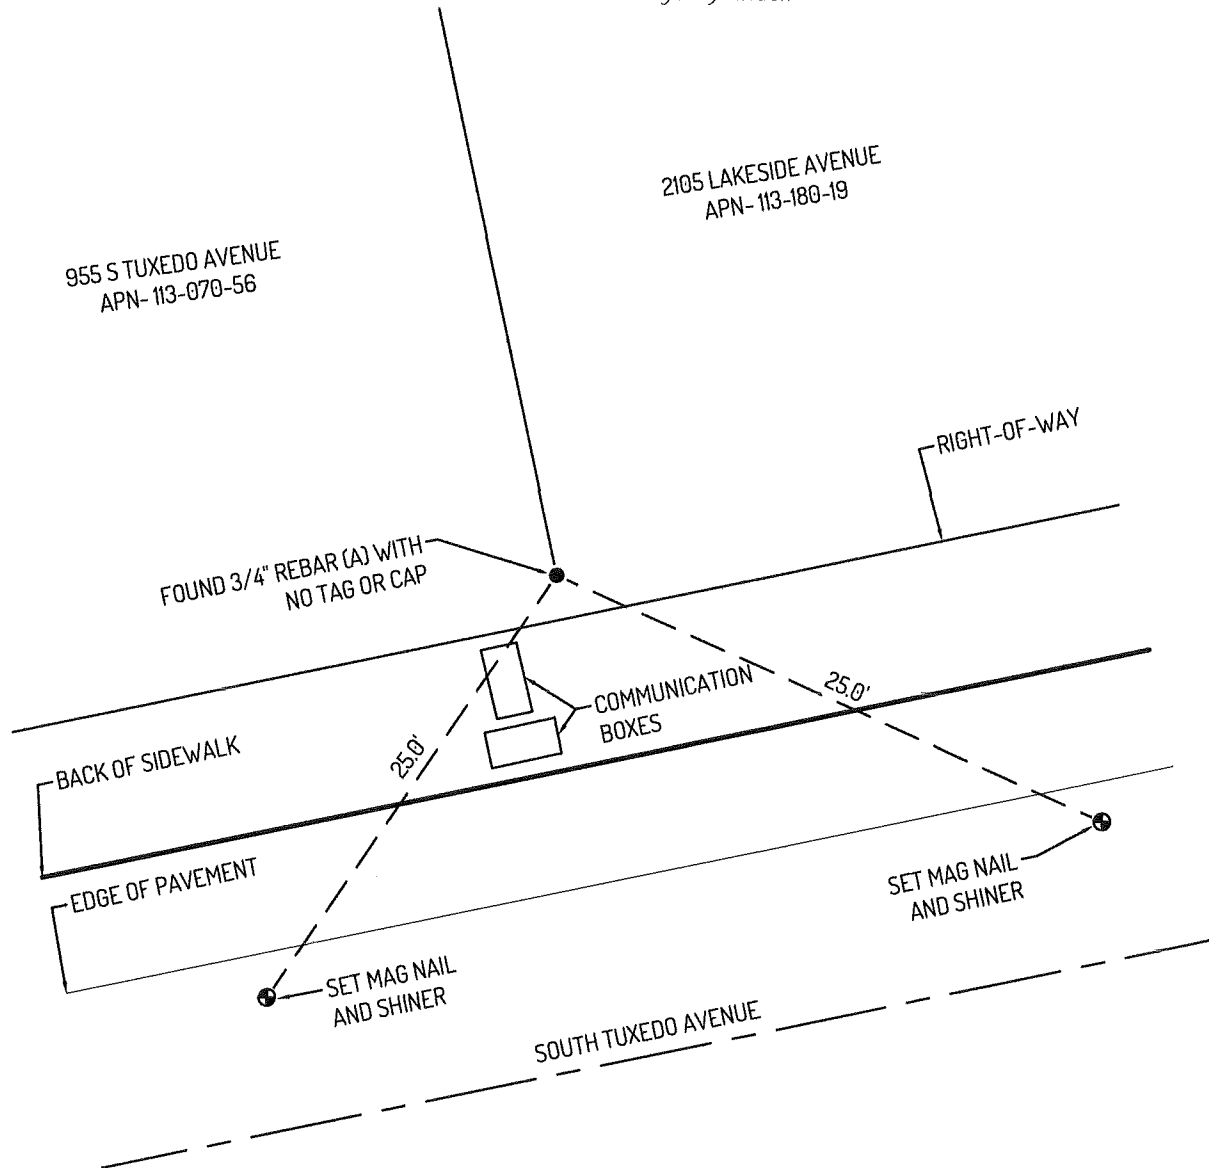

## LEGEND

- FOUND 3/4" REBAR (A) NO CAP OR TAG
- ⊙— SET CONTROL POINT
- 955 REFERENCE STREET ADDRESS
- APN ASSESSOR'S PARCEL NUMBER
- MP MAPS AND PLATS, SAN JOAQUIN COUNTY RECORDS

## LINETYPES

- — — CENTERLINE
- — — SIDEWALK
- — — EDGE OF PAVEMENT
- — — RIGHT OF WAY
- — — TIE LINE

## REFERENCE

(A) MONUMENT NOT OF RECORD.

