

CORNER RECORD

Agency Index

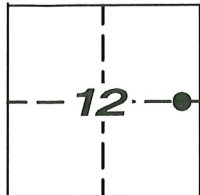
CR-23-011

Document Number

City of LODI

County of SAN JOAQUIN, California

Brief Legal Description INTERSECTION OF CHERRY STREET AND GARFIELD STREET

CORNER TYPE**COORDINATES (Optional)**

T.3N, R.6E

- ☐ Government Corner ☐ Control
☐ Meander ☒ Property
☐ Rancho ☐ Other

N. _____ E. _____
Elevation _____
Units ☐ Metric ☐ U.S. Survey Foot
Horizontal Datum _____
Zone _____ Epoch Date _____
Vertical Datum _____

Date of Survey 10/28/2022

- ☐ Complies with Public Resources Code §§8801-8819
☐ Complies with Public Resources Code §§8890-8902

PLS Act Ref: ☐ 8765(d) ☒ 8771 ☐ 8773 ☐ Other:
Corner/Monument: ☒ Left as found ☐ Established ☐ Rebuilt ☐ Pre-Construction
☐ Found and tagged ☐ Reestablished ☐ Referenced ☒ Post-Construction

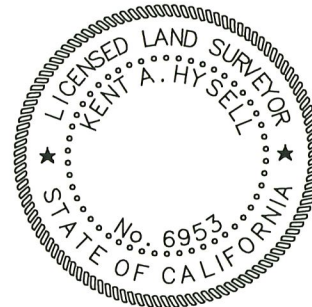
Narrative of corner identified and monument as found, set, reset, replaced, or removed:

☐ See sheet #2 for description (s):

FOUND THREE (3) CONCRETE NAILS WITH BRASS TAG "LS 6953" WITNESS CORNERS PER (R1); SET TWO (2) CONCRETE NAILS WITH BRASS TAG "LS 6953", ALL AS SHOWN ON SHEET 2.

SURVEYOR'S STATEMENT

This Corner Record was prepared by me or under my direction in conformance with the Professional Land Surveyors' Act on DECEMBER 28, 2022

Signed [Signature] P.L.S. or R.G.E. No. 6953**COUNTY SURVEYOR'S STATEMENT**

This Corner Record was received December 29, 2022
and examined and filed January 6, 2023

Signed James E. Hart P.L.S. or R.G.E. No. 8657Title County Surveyor

County Surveyor's Comment _____

10-M&P-84

047-314-01

ALLEY

"E"

"D"

GARFIELD STREET

047-311-14

047-311-15

047-312-10

SCALE: 1" = 30'

REFERENCE:

(R1) CR-22-282, S.J.C.S.R.

X AND DISTANCE TABLE

BS-@-FS	X	FS DISTANCE
C-A-C	00°00'00"	171.68'(M)
C-A-B	00°00'00"	81.399'(M)
C-A-D	182°27'27"	74.772'(M)
C-A-E	167°32'16"	77.753'(M)

CHERRY STREET

"A"

"B"

"C"

047-312-09

047-312-08

NOTE:

THIS CORNER RECORD DOES NOT VERIFY THIS MONUMENT TO BE IN THE CORRECT POSITION.

LEGEND:

SET CONCRETE NAIL WITH BRASS TAG "LS 6953".



FOUND CONCRETE NAIL WITH BRASS TAG "LS 6953" (R1)

-M&P- MAPS & PLATS

-PM- PARCEL MAP

CR CORNER RECORD

S.J.C.S.R. SAN JOAQUIN COUNTY SURVEYOR'S RECORDS

(M) MEASURED DISTANCE. ALL DISTANCES ARE MEASURED UNLESS NOTED OTHERWISE.