
CORNER RECORD

CR-23-037 Agency Index Document Number City of RIPON County of SAN JOAQUIN EAST 1/4 CORNER OF SEC. 30, T2S, R8E, M.D.B.M. Brief Legal Description **COORDINATES (Optional) CORNER TYPE** E. X Government Corner Control Elevation SEC Metric U.S. Survey Foot Meander Property Units X Rancho Other Horizontal Datum 30 Zone Epoch Date Date of Survey September 22, 2022 Vertical Datum Complies with Public Resources Code §§8801-8819 Complies with Public Resources Code §§8890-8902 8765(d) **X** 8771 8773 Other: PLS Act Ref.: Pre-Construction Left as found Established Rebuilt Corner/ **Monument:** Nost-Construction Found and tagged Reestablished Referenced Narrative of corner identified and monument as found, set, reset, replaced, or removed: See sheet #2 for description(s): **SURVEYOR'S STATEMENT** This Corner Record was prepared by me or under my direction in conformance with the Professional Land Surveyors' Act on November 11, 2022 P.L.S. or R.C.E. No. Signed **COUNTY SURVEYOR'S STATEMENT** January 4, 2023 This Corner Record was received Anuary 13, 2023.

Hart P.L.S. OFR.C.E. No. 8657 and examined and filed Signed Title

County Surveyor's Comment

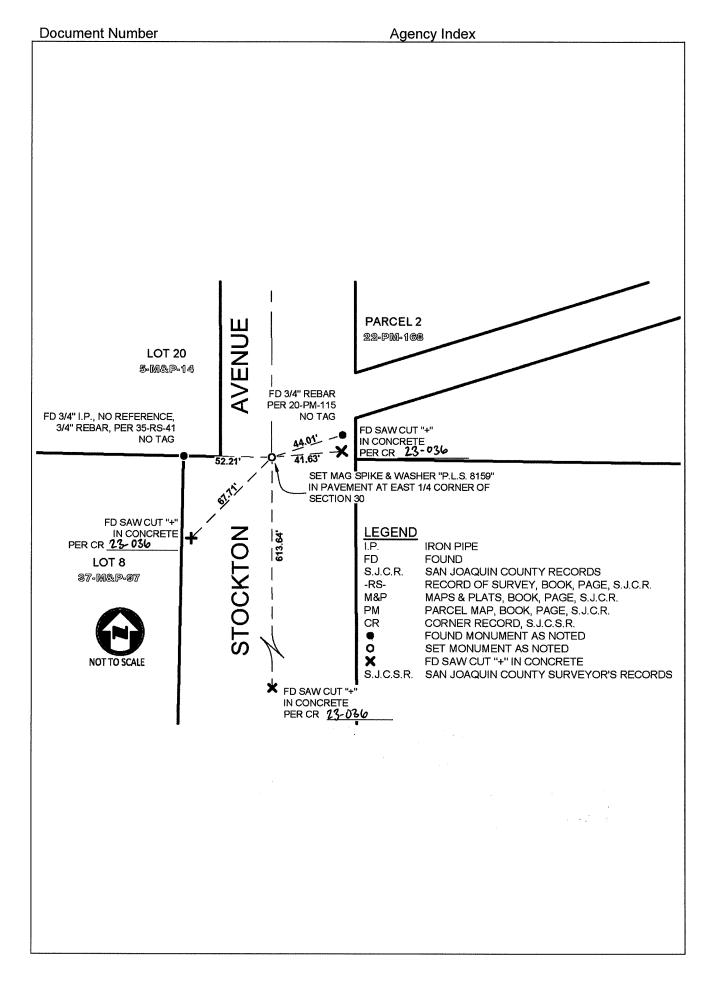

BPELSG-2016 Page 2 of 2