
## CORNER RECORD

Agency Index <u>CR-23-038</u> Document Number RIPON County of SAN JOAQUIN Brief Legal Description NE. 1/4 SEC. 30, T2S, R8E, M.D.B.M. **CORNER TYPE COORDINATES (Optional)** E. \_\_\_\_\_ Elevation Government Corner Control U.S. Survey Foot Units Metric Meander Property Rancho Other Horizontal Datum Zone Epoch Date \_\_\_\_\_ Date of Survey July 14, 2021 Vertical Datum Complies with Public Resources Code §§8801-8819 Complies with Public Resources Code §§8890-8902 Other: 8765(d) **X** 8771 8773 PLS Act Ref.: Pre-Construction Left as found Established Rebuilt Corner/ Monument: Referenced Post-Construction Found and tagged Reestablished Narrative of corner identified and monument as found, set, reset, replaced, or removed: See sheet #2 for description(s): SURVEYOR'S STATEMENT This Corner Record was prepared by me or under my direction in conformance with August 12, 2022 the Professional Land Surveyors' Act on P.L.S. or R.C.E. No. Signed **COUNTY SURVEYOR'S STATEMENT** January 4, 2023 Anuary 13, 2023

P.L.S. OFR.C.E. No. 8657 This Corner Record was received and examined and filed Signed

**County Surveyor's Comment** 

Title

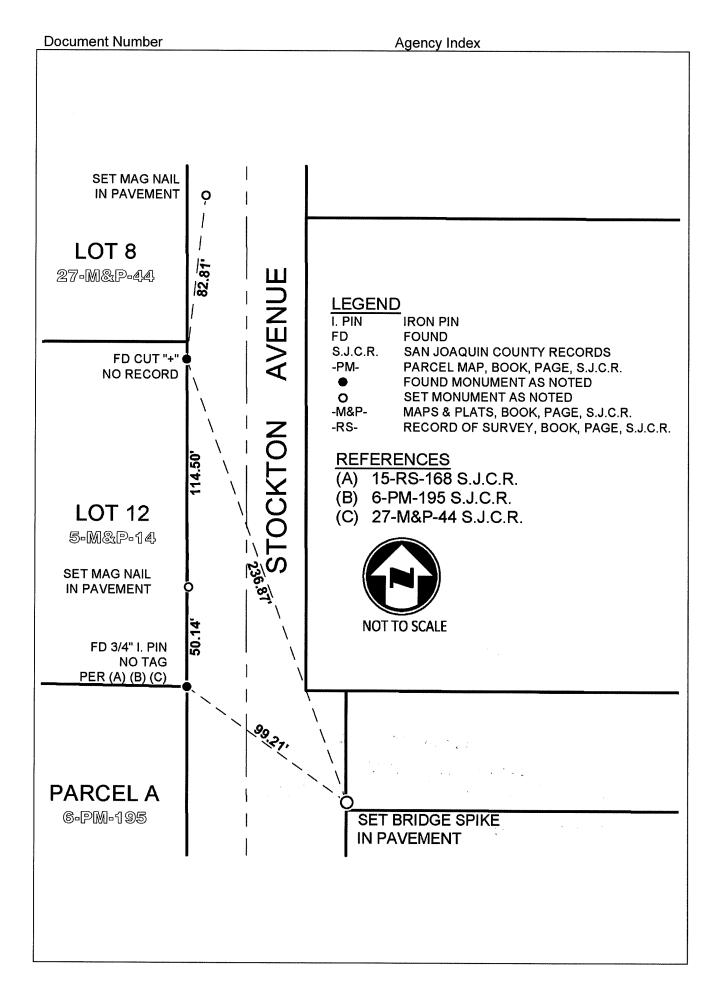

BPELSG-2016 Page 2 of 2