
## **CORNER RECORD**

Agency Index \_\_\_\_\_CR- 23-039 **Document Number** RIPON County of SAN JOAQUIN , California City of NE. 1/4 SEC. 30, T2S, R8E, M.D.B.M. Brief Legal Description **COORDINATES (Optional) CORNER TYPE** E. \_\_\_\_ Elevation Government Corner Control U.S. Survey Foot Meander X Property Units Metric Rancho Other Horizontal Datum Zone Epoch Date Date of Survey September 22, 2022 Vertical Datum Complies with Public Resources Code §§8801-8819 Complies with Public Resources Code §§8890-8902 8771 Other: 8765(d) 8773 PLS Act Ref.: **Pre-Construction** Left as found Established Rebuilt Corner/ **Monument:** Post-Construction Found and tagged Reestablished Referenced Narrative of corner identified and monument as found, set, reset, replaced, or removed: See sheet #2 for description(s): **SURVEYOR'S STATEMENT** This Corner Record was prepared by me or under my direction in conformance with the Professional Land Surveyors' Act on November 11, 2022 P.L.S. or R.C.E. No. Signed **COUNTY SURVEYOR'S STATEMENT** January 4, 2023 This Corner Record was received and examined and filed Signed Title **County Surveyor's Comment** 

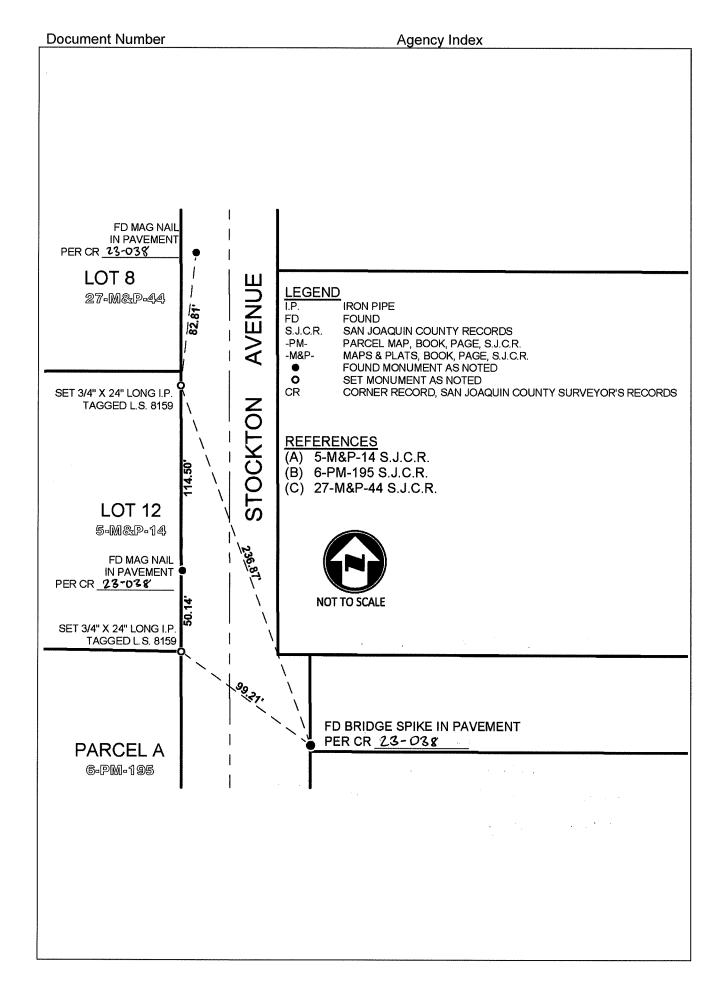

BPELSG-2016 Page 2 of 2