
## **CORNER RECORD**

**Document Number** County of SAN JOAQUIN RIPON Brief Legal Description STOCKTON AVENUE & 5th STREET, NE. 1/4 SEC. 30, T2S, R8E, M.D.B.M. **COORDINATES (Optional) CORNER TYPE** E. \_\_\_\_ Government Corner Elevation Control U.S. Survey Foot Meander Property Units Metric Other Rancho Horizontal Datum **Epoch Date** Zone Date of Survey July 14, 2021 Vertical Datum Complies with Public Resources Code §§8801-8819 Complies with Public Resources Code §§8890-8902 **X** 8771 Other: PLS Act Ref.: 8765(d) 8773 **Pre-Construction** Left as found Established Rebuilt Corner/ Monument: Post-Construction Found and tagged Reestablished X Referenced Narrative of corner identified and monument as found, set, reset, replaced, or removed: See sheet #2 for description(s): SURVEYOR'S STATEMENT This Corner Record was prepared by me or under my direction in conformance with the Professional Land Surveyors' Action August 12, 2022 P.L.S. or R.C.E. No. Signed **COUNTY SURVEYOR'S STATEMENT** January 4, 2023 This Corner Record was received and examined and filed Signed Title

CR-23-040

Agency Index

**County Surveyor's Comment** 

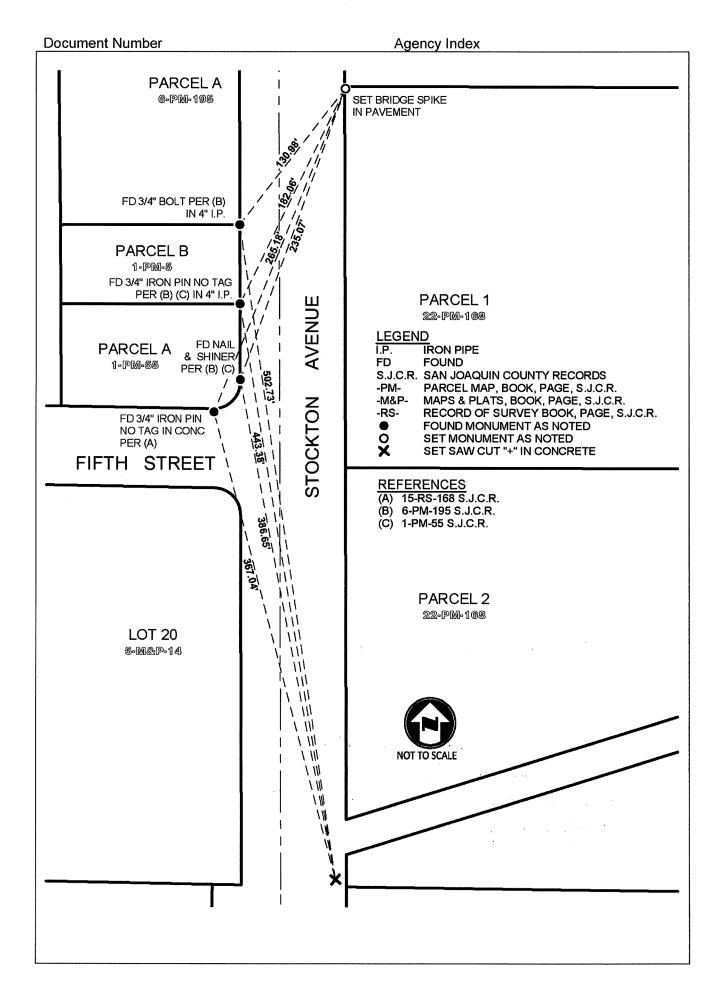

BPELSG-2016 Page 2 of 2