


CORNER RECORD

Agency Index CR-23-093
Document Number _____

City of Tracy, unincorporated County of San Joaquin, California
Brief Legal Description Portion of Section 35, Township 2 South, Range 4 East, MDBM and Section 2, Township 3 South, Range 4 East, MDBM

CORNER TYPE

COORDINATES (Optional)

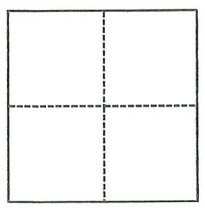

- Government Corner
- Meander
- Rancho
- Control
- Property
- Other

Date of Survey 12/06/21

N. _____ E. _____
 Elevation _____
 Units Metric U.S. Survey Foot
 Horizontal Datum _____
 Zone _____ Epoch Date _____
 Vertical Datum _____
 Complies with Public Resources Code §§8801-8819
 Complies with Public Resources Code §§8890-8902

- PLS Act Ref.: 8765(d) 8771 8773 Other: _____
- Corner/Monument: Left as found Established Rebuilt Pre-Construction
 Found and tagged Reestablished Referenced Post-Construction

Narrative of corner identified and monument as found, set, reset, replaced, or removed:
 See sheet #2 for description(s):

SURVEYOR'S STATEMENT

This Corner Record was prepared by me or under my direction in conformance with
 the Professional Land Surveyors' Act on January 1, 2022
 Signed Ekundayo Sowumi P.L.S. or R.C.E. No. 22573




COUNTY SURVEYOR'S STATEMENT

This Corner Record was received March 8, 2023
 and examined and filed March 30, 2023
 Signed James E. Hart P.L.S. or R.C.E. No. 8657
 Title County Surveyor



County Surveyor's Comment

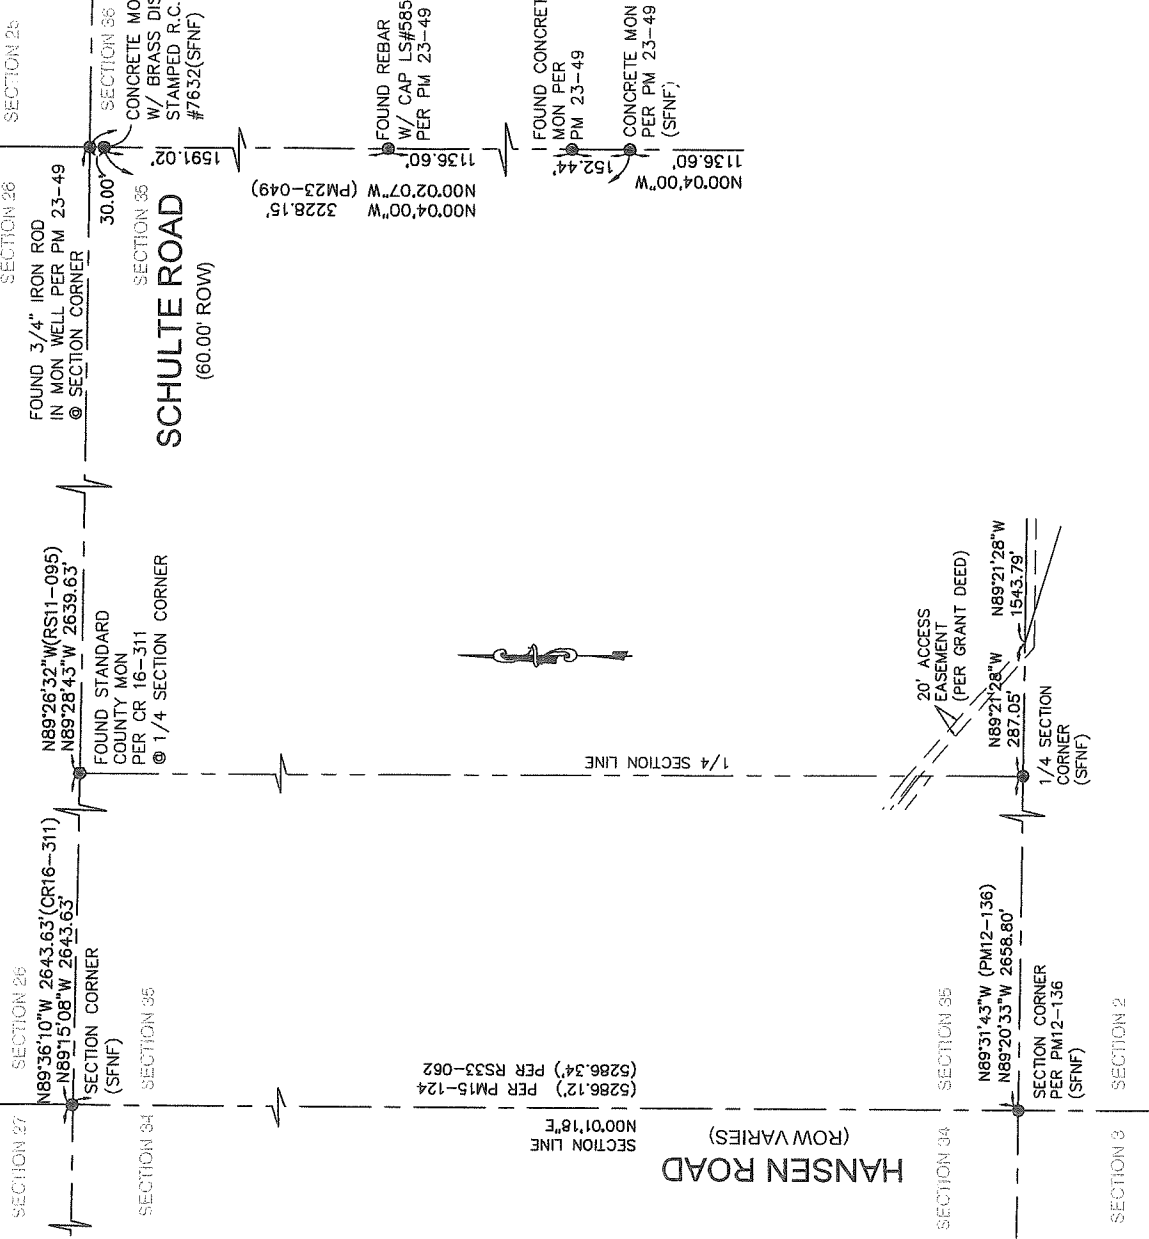

ABBREVIATIONS AND LEGEND

- FOUND MONUMENT AS NOTED
- FOUND IRON PIPE W/ TAG LS#4379
- SET 1/2"x18" REBAR WITH CAP R.C.E.#22573
- FOUND 3/4" REBAR WITH CAP LS#4379
- PROPERTY LINE
- MONUMENT LINE
- EASEMENT LINE
- OLD LOT LINE
- SFNF SEARCH FOR NOT FOUND
- R.C.E. REGISTER CIVIL ENGINEER
- PM PARCEL MAP, SUCR
- RS RECORD OF SURVEY, SUCR
- CR CORNER RECORD, SUCR
- SUCR SAN JOAQUIN COUNTY RECORDS
- SUCSR SAN JOAQUIN COUNTY SURVEYOR'S RECORDS
- O.R. OFFICIAL RECORDS, SUCR
- MON MONUMENT

CORNER RECORD

26722 HANSEN ROAD, TRACY CA 95377

JANUARY 1, 2022

SCALE: 1"=400'