
## CR-23-097 Agency Index: CORNER RECORD Document Number: SAN JOAQUIN , California County of \_\_\_\_\_ Brief Legal Description TWO MONUMENTS AT THE INTERSECTION OF DEL MAR AVENUE AND EAST MAIN STREET COORDINATES (Optional) CORNER TYPE Government Corner Control Elevation Meander Property Metric U.S. Survey Foot Units Other Rancho Horizontal Datum Zone \_\_\_\_\_ Epoch Date \_\_\_\_\_ 01-24-2023 Date of Survey Vertical Datum C.M. WEBER GRANT Complies with Public Resources Code §§8801-8819 Complies with Public Resources Code §§8890-8902 8765(d) **X** 8771 8773 Other: PLS Act Ref: ▼ Pre-Construction Left as found Established Rebuilt Corner/ ☐ Post—Construction Found and Tagged Reestablished Referenced Monument: Narrative of corner identified and monument as found, set, reset, replaced, or removed: See sheet #2 for description(s): FOUND MONUMENTS AS SHOWN ON SHEET 2. SURVEYOR'S STATEMENT LAND This Corner Record was prepared by me or under my direction in conformance with KENT A. HYSELL JANUARY 25 the Land Surveyors' Act on ND. 6953 P.L.S. or <del>R.C.E.</del> Number \_\_ 6953 COUNTY SURVEYOR'S STATEMENT and examined and filed March 30, Z023 P.L.S. or R.C.E. No: 8657 This Corner Record was received \_\_\_ County Surveyor's Comment \_\_\_

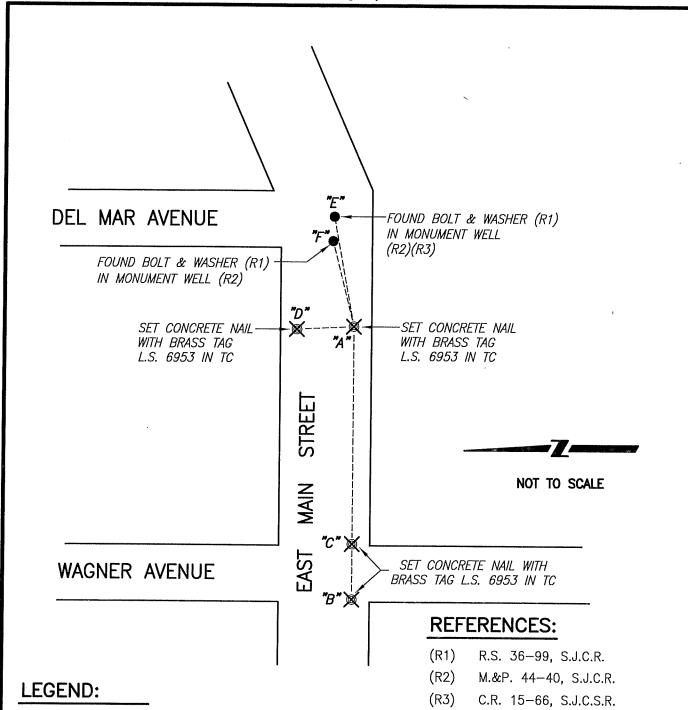

SET MONUMENT AS NOTED.

FOUND MONUMENT AS NOTED.

TC DENOTES TOP-OF-CURB

R.S. DENOTES RECORD OF SURVEY

M.&P. DENOTE MAPS AND PLATS

S.J.C.R. DENOTES SAN JOAQUIN COUNTY RECORDS

S.J.C.S.R. DENOTES SAN JOAQUIN COUNTY SURVEYORS RECORDS

(M) MEASURED DISTANCE. ALL DISTANCES ARE MEASURED

UNLESS NOTED OTHERWISE.

¾ AND DISTANCE TABLE		
BS-@-FS	¥.	FS DISTANCE
BAB	00'00'00"	277.850'(M)
B-A-C	<i>359*59'09"</i>	159.656'(M)
B-A-D	89 <b>*</b> 36 <b>'</b> 38"	64.060'(M)
B–A–E	150:47'10"	71.035'(M)
BAF	147'22'10"	59.241'(M)