


# CORNER RECORD

Agency Index CR-23-099  
 Document Number \_\_\_\_\_

City of Lathrop County of San Joaquin, California  
 Brief Legal Description Thomsen Rd. between Fairview & Warfield, Section 26, T.1S., R.6E., M.D.B.& M.

### CORNER TYPE

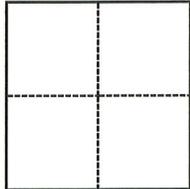

- Government Corner     Control  
 Meander                 Property  
 Rancho                     Other

Date of Survey December 7, 2022

### COORDINATES (Optional)

N. \_\_\_\_\_ E. \_\_\_\_\_  
 Elevation \_\_\_\_\_  
 Units     Metric     U.S. Survey Foot  
 Horizontal Datum \_\_\_\_\_  
 Zone \_\_\_\_\_ Epoch Date \_\_\_\_\_  
 Vertical Datum \_\_\_\_\_  
 Complies with Public Resources Code §§8801-8819  
 Complies with Public Resources Code §§8890-8902

PLS Act Ref.:     8765(d)                 8771                 8773                 Other:  
 Corner/  
 Monument:     Left as found                 Established                 Rebuilt                 Pre-Construction  
                       Found and tagged                 Reestablished                 Referenced                 Post-Construction

Narrative of corner identified and monument as found, set, reset, replaced, or removed:  
 See sheet #2 for description(s):



### SURVEYOR'S STATEMENT


This Corner Record was prepared by me or under my direction in conformance with  
 the Professional Land Surveyors' Act on January 26, 2023  
 Signed Douglas F. Banks P.L.S. or R.C.E. No. 8159

### COUNTY SURVEYOR'S STATEMENT

This Corner Record was received March 23, 2023  
 and examined and filed March 30, 2023  
 Signed James E. Hart P.L.S. or R.C.E. No. 8657  
 Title County Surveyor



County Surveyor's Comment

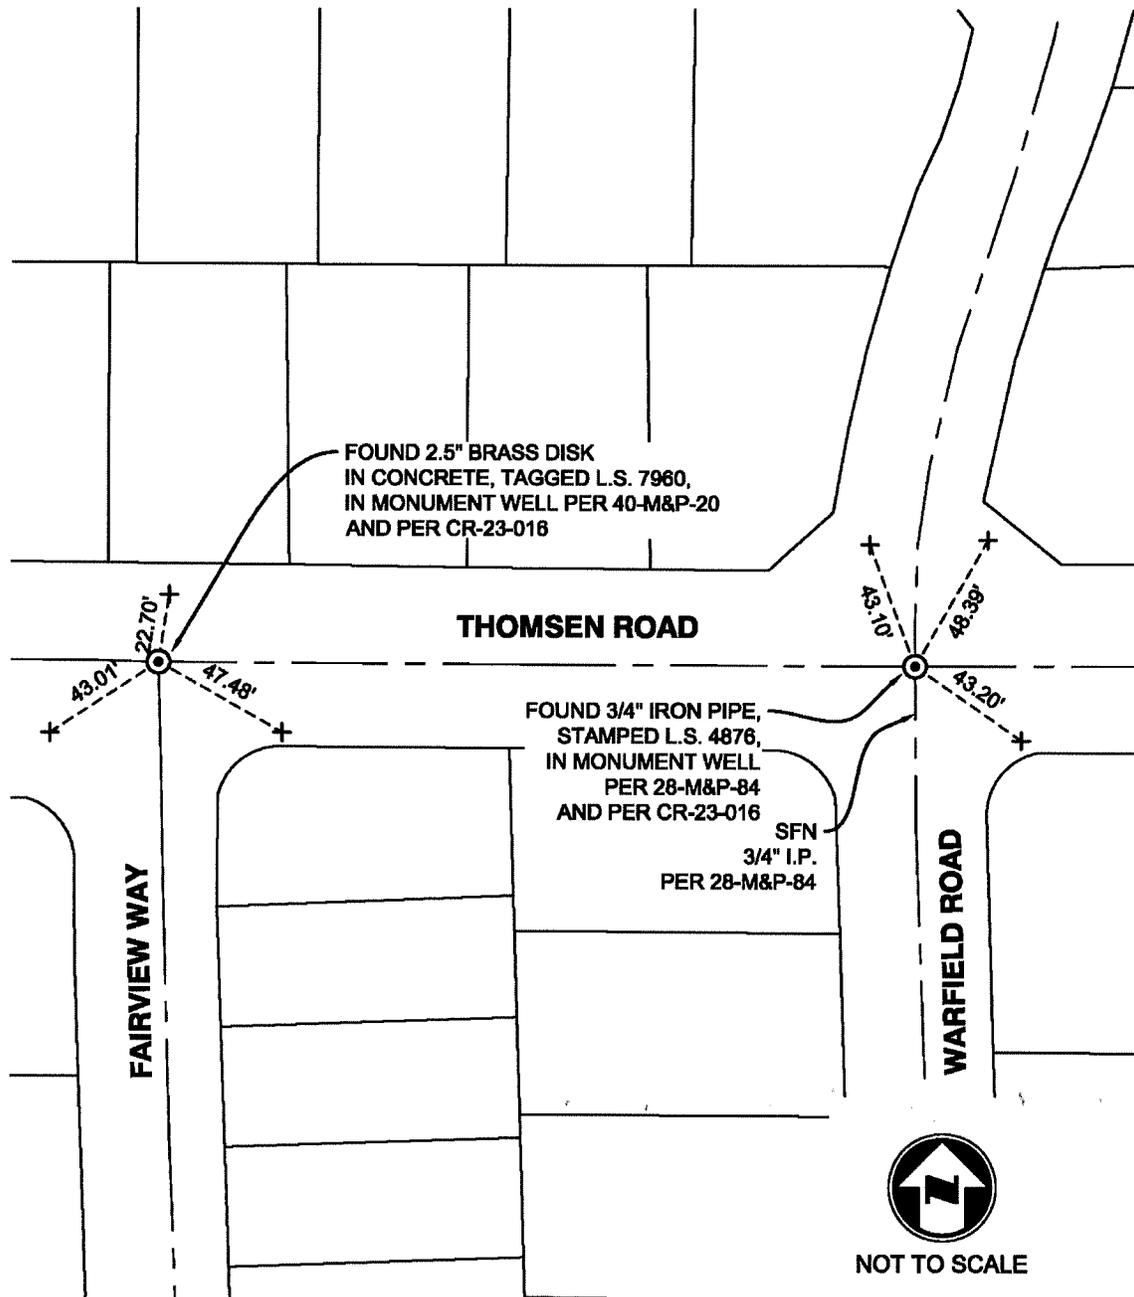

**NOTES:**

- ⊙ FOUND MONUMENT AS NOTED.
- + FOUND SAW CUT "+" IN CONCRETE ON TOP OF CURB, PER CR-23-016
- M&P- BOOK, PAGE, MAPS AND PLATS, SAN JOAQUIN COUNTY RECORDS
- SFN SEARCHED, FOUND NOTHING
- I.P. IRON PIPE
- CR- CORNER RECORD, SAN JOAQUIN COUNTY SURVEYOR'S RECORDS