


CORNER RECORD

Agency Index CR-23-136
Document Number _____

City of LODI County of SAN JOAQUIN, California
Brief Legal Description PARCEL MAP 3-132, SAN JOAQUIN COUNTY RECORDS

CORNER TYPE

COORDINATES (Optional)

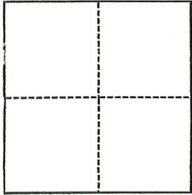

- Government Corner Control
 Meander Property
 Rancho Other

Date of Survey February 7, 2023

N. _____ E. _____
 Elevation _____
 Units Metric U.S. Survey Foot
 Horizontal Datum _____
 Zone _____ Epoch Date _____
 Vertical Datum _____
 Complies with Public Resources Code §§8801-8819
 Complies with Public Resources Code §§8890-8902

- PLS Act Ref.: 8765(d) 8771 8773 Other:
 Corner/
 Monument: Left as found Established Rebuilt Pre-Construction
 Found and tagged Reestablished Referenced Post-Construction

Narrative of corner identified and monument as found, set, reset, replaced, or removed:
 See sheet #2 for description(s):

SEE SHEET 2 FOR MONUMENTS FOUND AND SET

SURVEYOR'S STATEMENT

This Corner Record was prepared by me or under my direction in conformance with
 the Professional Land Surveyors' Act on 04/06/2023
 Signed Walter John Shoup P.L.S. or R.C.E. No. 7736







COUNTY SURVEYOR'S STATEMENT

This Corner Record was received April 6, 2023
 and examined and filed April 14, 2023
 Signed James E. Hart P.L.S. or R.C.E. No. 8657
 Title County Surveyor



County Surveyor's Comment

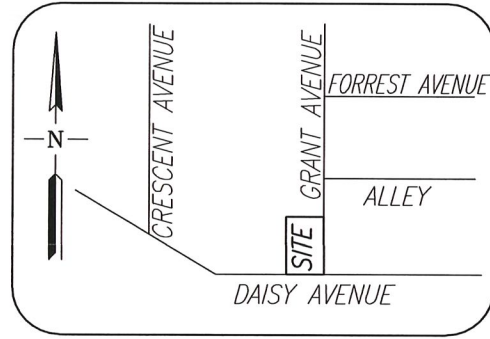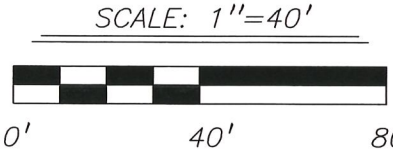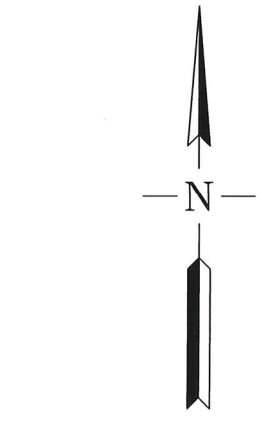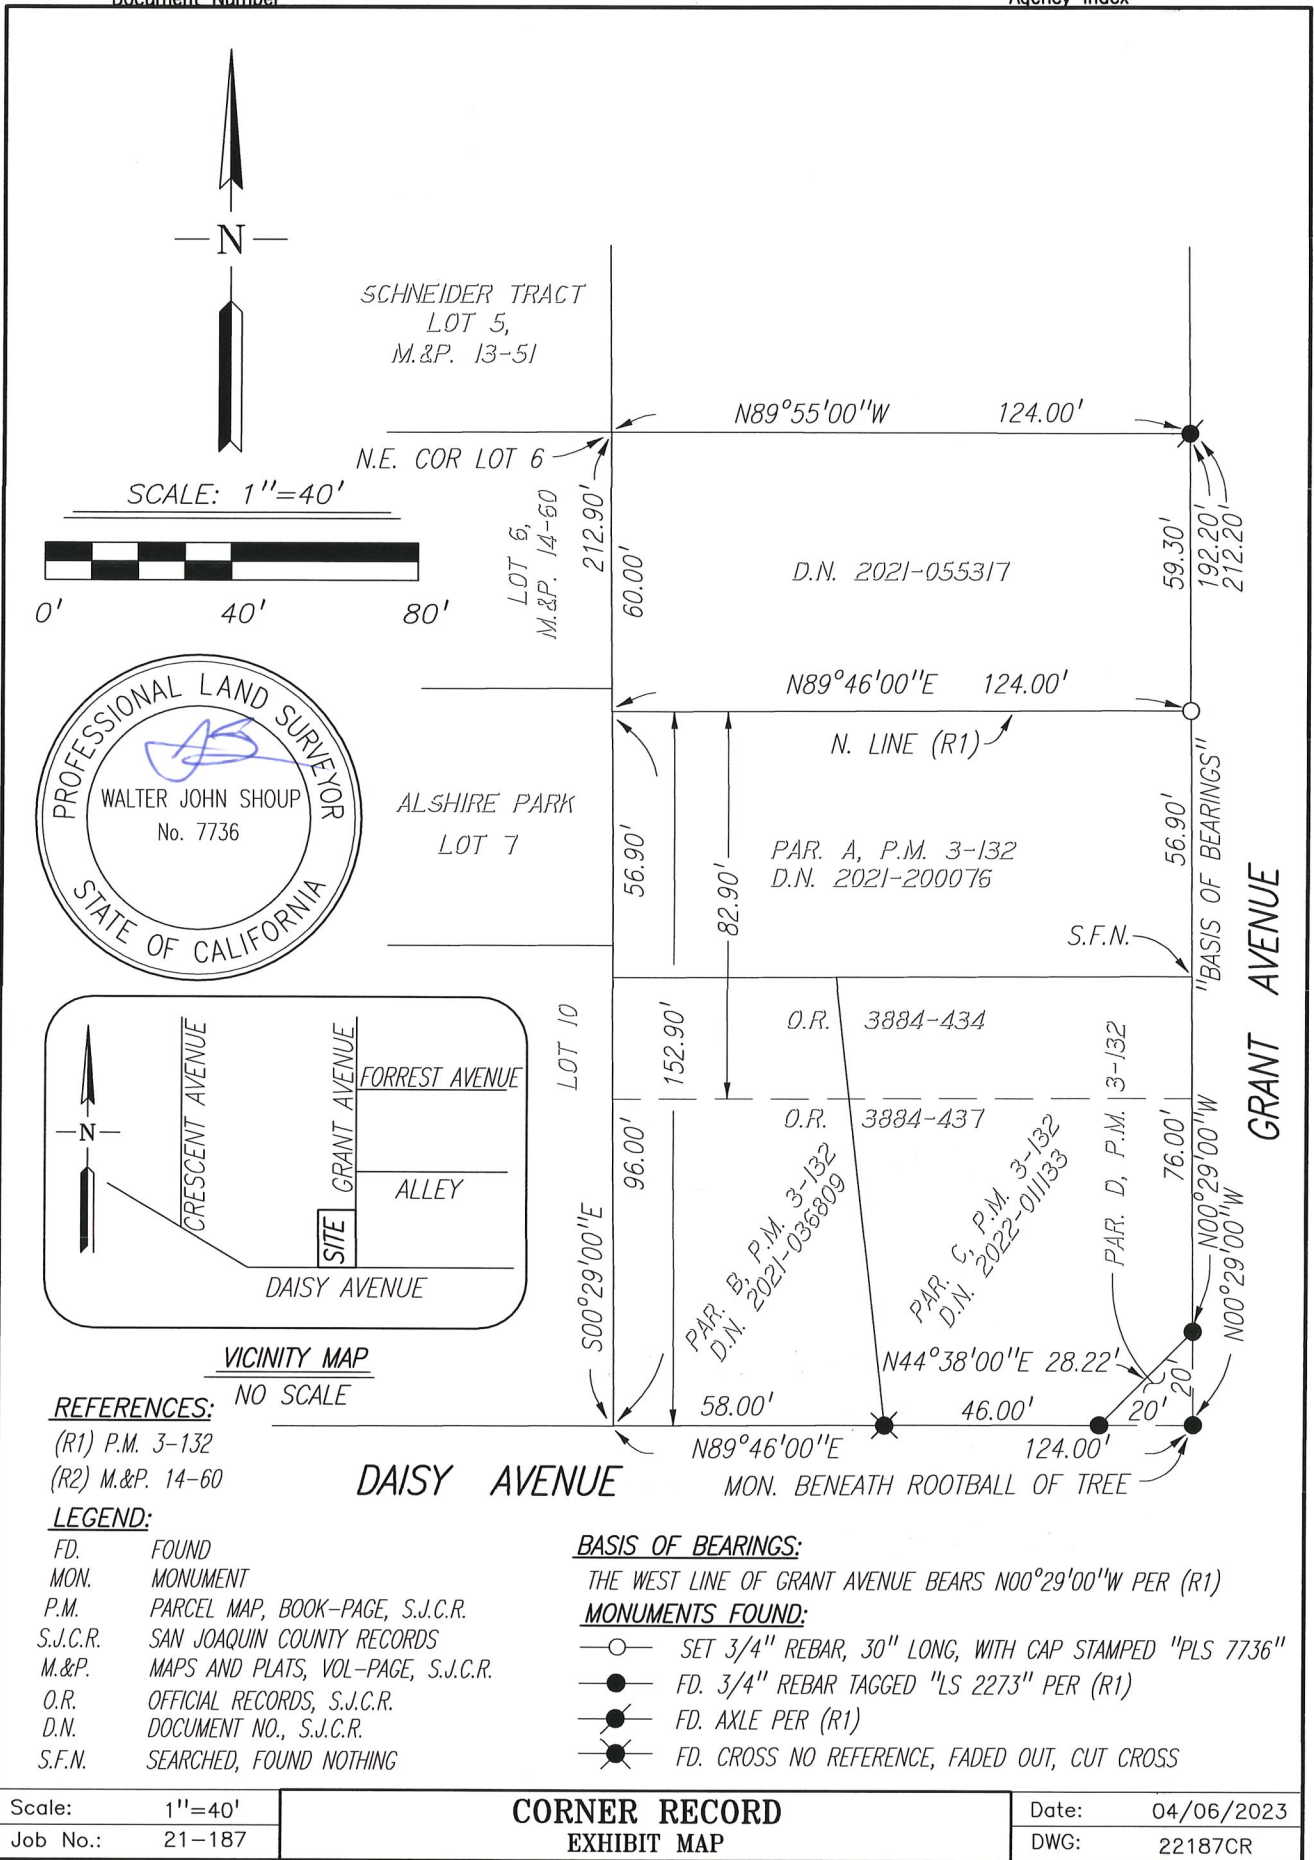

VICINITY MAP

- REFERENCES:** NO SCALE
- (R1) P.M. 3-132
 - (R2) M.&P. 14-60

- LEGEND:**
- FD. FOUND
 - MON. MONUMENT
 - P.M. PARCEL MAP, BOOK-PAGE, S.J.C.R.
 - S.J.C.R. SAN JOAQUIN COUNTY RECORDS
 - M.&P. MAPS AND PLATS, VOL-PAGE, S.J.C.R.
 - O.R. OFFICIAL RECORDS, S.J.C.R.
 - D.N. DOCUMENT NO., S.J.C.R.
 - S.F.N. SEARCHED, FOUND NOTHING

- BASIS OF BEARINGS:**
- THE WEST LINE OF GRANT AVENUE BEARS N00°29'00"W PER (R1)
- MONUMENTS FOUND:**
- SET 3/4" REBAR, 30" LONG, WITH CAP STAMPED "PLS 7736"
 - FD. 3/4" REBAR TAGGED "LS 2273" PER (R1)
 - FD. AXLE PER (R1)
 - ⊗ FD. CROSS NO REFERENCE, FADED OUT, CUT CROSS

Scale: 1"=40'	CORNER RECORD EXHIBIT MAP	Date: 04/06/2023
Job No.: 21-187		DWG: 22187CR