
CORNER RECORD

CR-23-144 Agency Index **Document Number** City of STOCKTON County of SAN JOAQUIN . California Brief Legal Description MONUMENT AT THE INTERSECTION OF ANDERSON STREET AND BIEGHLE ALLEY **CORNER TYPE COORDINATES (Optional)** Control Elevation Government Corner ☐ U.S. Survey Foot Meander Property Units Metric Rancho Other | Horizontal Datum Zone _____Epoch Date Date of Survey JANUARY 21, 2022 Vertical Datum Complies with Public Resources Code §\$8801-8819 Complies with Public Resources Code §\$8890-8902 8771 8773 PLS Act Ref.: 8765(d) Other: Left as found Established Rebuilt Corner/ Monument: Found and tagged Reestablished X Referenced Post-Construction Narrative of corner identified and monument as found, set, reset, replaced, or removed: J See sheet #2 for description(s): FOUND 3/4" REBAR WITH NO PUNCH IN MONUMENT BOX, AS SHOWN ON RECORD OF SURVEY MAP, BOOK 32 AT PAGE 27, SAN JOAQUIN COUNTY RECORDS. MONUMENT WAS REFERENCED PRIOR TO THE START OF CONSTRUCTION OF A WATER MAIN REPLACEMENT. PROJECT NO. STK-18AB2 BY CALIFORNIA WATER SERVICE. SURVEYOR'S STATEMENT This Corner Record was prepared by me or under my direction in conformance with the Professional Land Surveyors' Act on MAY 5, 2022 P.L.S. or R.C.E. No. **9251** Signed No. 9251 **COUNTY SURVEYOR'S STATEMENT** This Corner Record was received and examined and filed Signed Title **County Surveyor's Comment**

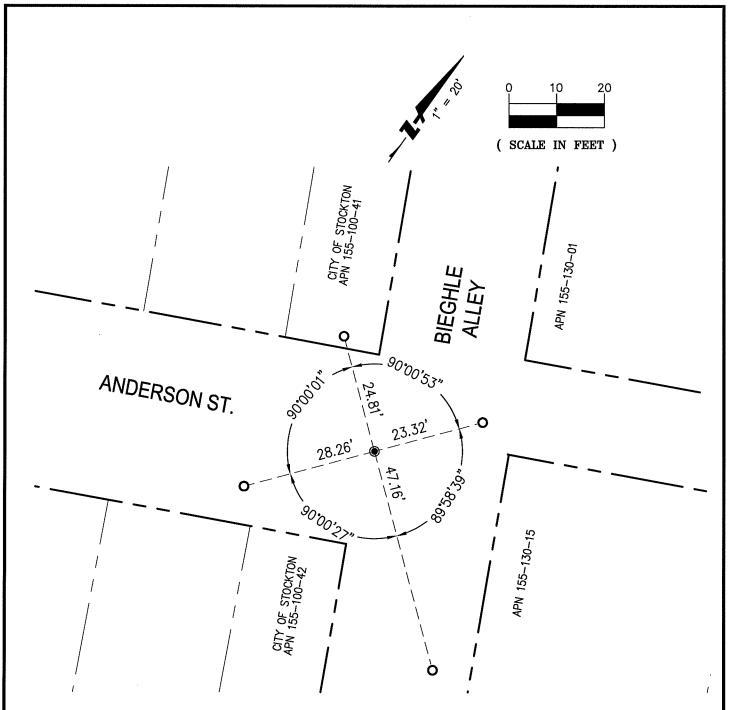

LEGEND

- FOUND 3/4" REBAR WITH NO PUNCH IN MONUMENT BOX, AS SHOWN ON RECORD OF SURVEY MAP, BOOK 32 AT PAGE 27, SAN JOAQUIN COUNTY RECORDS.
- O SET MAG NAIL ON TOP OF CURB.



SUBJECT PRE-CONSTRUCTION CORNER RECORD
AT ANDERSON STREET AND BIEGHLE ALLEY

JOB NO. 20191483-STOCKTON MON PRESERVATION
BY JML/EC APPR. BHS DATE 05-05-2022