

# CORNER RECORD


Agency Index

CR-23-145

Document Number

City of STOCKTONCounty of SAN JOAQUIN

, California

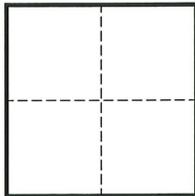Brief Legal Description MONUMENT AT THE INTERSECTION OF EAST WORTH STREET AND BIEGHLE ALLEY**CORNER TYPE****COORDINATES (Optional)**

- Government Corner     Control  
 Meander     Property  
 Rancho     Other

Date of Survey JANUARY 21, 2022

N. \_\_\_\_\_ E. \_\_\_\_\_  
 Elevation \_\_\_\_\_  
 Units  Metric  U.S. Survey Foot  
 Horizontal Datum \_\_\_\_\_  
 Zone \_\_\_\_\_ Epoch Date \_\_\_\_\_  
 Vertical Datum \_\_\_\_\_  
 Complies with Public Resources Code §§8801-8819  
 Complies with Public Resources Code §§8890-8902

PLS Act Ref.:  8765(d)     8771     8773     Other:  
 Corner/Monument:  Left as found     Established     Rebuilt     Pre-Construction  
 Found and tagged     Reestablished     Referenced     Post-Construction

Narrative of corner identified and monument as found, set, reset, replaced, or removed:


 See sheet #2 for description(s):

FOUND 3/4" REBAR WITH PUNCH IN MONUMENT BOX LOCATED AT THE INTERSECTION OF EAST WORTH STREET AND BIEGHLE ALLEY AS PER PARCEL MAP, BOOK 24 OF PARCEL MAPS AT PAGE 53, SAN JOAQUIN COUNTY RECORDS.

MONUMENT WAS REFERENCED PRIOR TO THE START OF CONSTRUCTION OF A WATER MAIN REPLACEMENT, PROJECT NO. STK-18AB2 BY CALIFORNIA WATER SERVICE.

**SURVEYOR'S STATEMENT**


This Corner Record was prepared by me or under my direction in conformance with

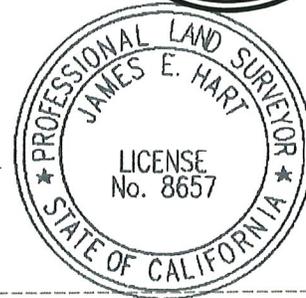
[Empty dashed box for County Surveyor's Comment]


APN 155-090-59

BIEGHLE ALLEY

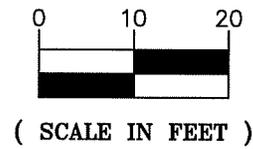

APN 155-160-01

E WORTH ST.

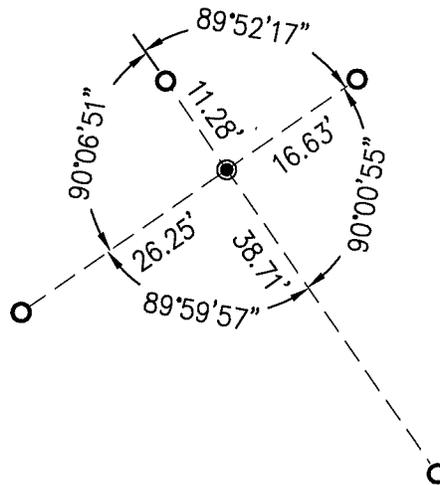

APN 155-090-17

BIEGHLE ALLEY

APN 155-160-03

### LEGEND

- FOUND 3/4" REBAR WITH PUNCH IN MONUMENT BOX AS PER PARCEL MAP, BOOK 24 OF PARCEL MAPS AT PAGE 53, SAN JOAQUIN COUNTY RECORDS.
- SET MAG NAIL ON TOP OF CURB.

**BKF**

1730 N. FIRST STREET  
 SUITE 600  
 SAN JOSE, CA 95112  
 (408) 467-9100  
 www.bkf.com

SUBJECT PRE-CONSTRUCTION CORNER RECORD  
AT EAST WORTH STREET AND BIEGHLE ALLEY

JOB NO. 20191483-STOCKTON MON PRESERVATION  
 BY JML/EC APPR. BHS DATE 05-05-2022

K:\DATA\191483-STOCKTON MON PRESERVATION\CORNER\_REC\_05-10-22\ORLE\_WORTH\_ST-BIEGHLE\_ALLEY.DWG