


# CORNER RECORD

Agency Index CR-23-149  
Document Number \_\_\_\_\_

City of Lodi County of San Joaquin, California  
Brief Legal Description Central Avenue between Kettleman Lane & Acacia Street (RS 4-152)

### CORNER TYPE

### COORDINATES (Optional)

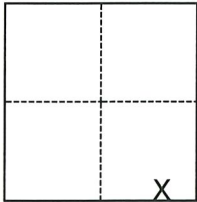

- Government Corner
- Meander
- Rancho
- Control
- Property
- Other

Date of Survey January 23, 2023

N. \_\_\_\_\_ E. \_\_\_\_\_  
 Elevation \_\_\_\_\_  
 Units  Metric  U.S. Survey Foot  
 Horizontal Datum \_\_\_\_\_  
 Zone \_\_\_\_\_ Epoch Date \_\_\_\_\_  
 Vertical Datum \_\_\_\_\_  
 Complies with Public Resources Code §§8801-8819  
 Complies with Public Resources Code §§8890-8902

Section 12,  
T.3N.,R.6E. M.D.B.&M.

- PLS Act Ref.:  8765(d)  8771  8773  Other:
- Corner/Monument:  Left as found  Established  Rebuilt  Pre-Construction  
 Found and tagged  Reestablished  Referenced  Post-Construction

Narrative of corner identified and monument as found, set, reset, replaced, or removed:  
 See sheet #2 for description(s):

THIS DOCUMENT IS FOR THE PURPOSE OF ESTABLISHING TIES TO EXISTING MONUMENTS IN THE AREA OF NEW CONSTRUCTION OF IMPROVEMENTS. FOUND AND SET MONUMENTS AS SHOWN ON PAGE 2. NO BOUNDARY ANALYSIS WAS PERFORMED.

### SURVEYOR'S STATEMENT

This Corner Record was prepared by me or under my direction in conformance with  
 the Professional Land Surveyors' Act on 4-18-23  
 Signed [Signature] P.L.S. or R.C.E. No. 9478




### COUNTY SURVEYOR'S STATEMENT

This Corner Record was received April 20, 2023  
 and examined and filed May 15, 2023  
 Signed James E. Hart P.L.S. or R.C.E. No. 8657  
 Title County Surveyor



County Surveyor's Comment

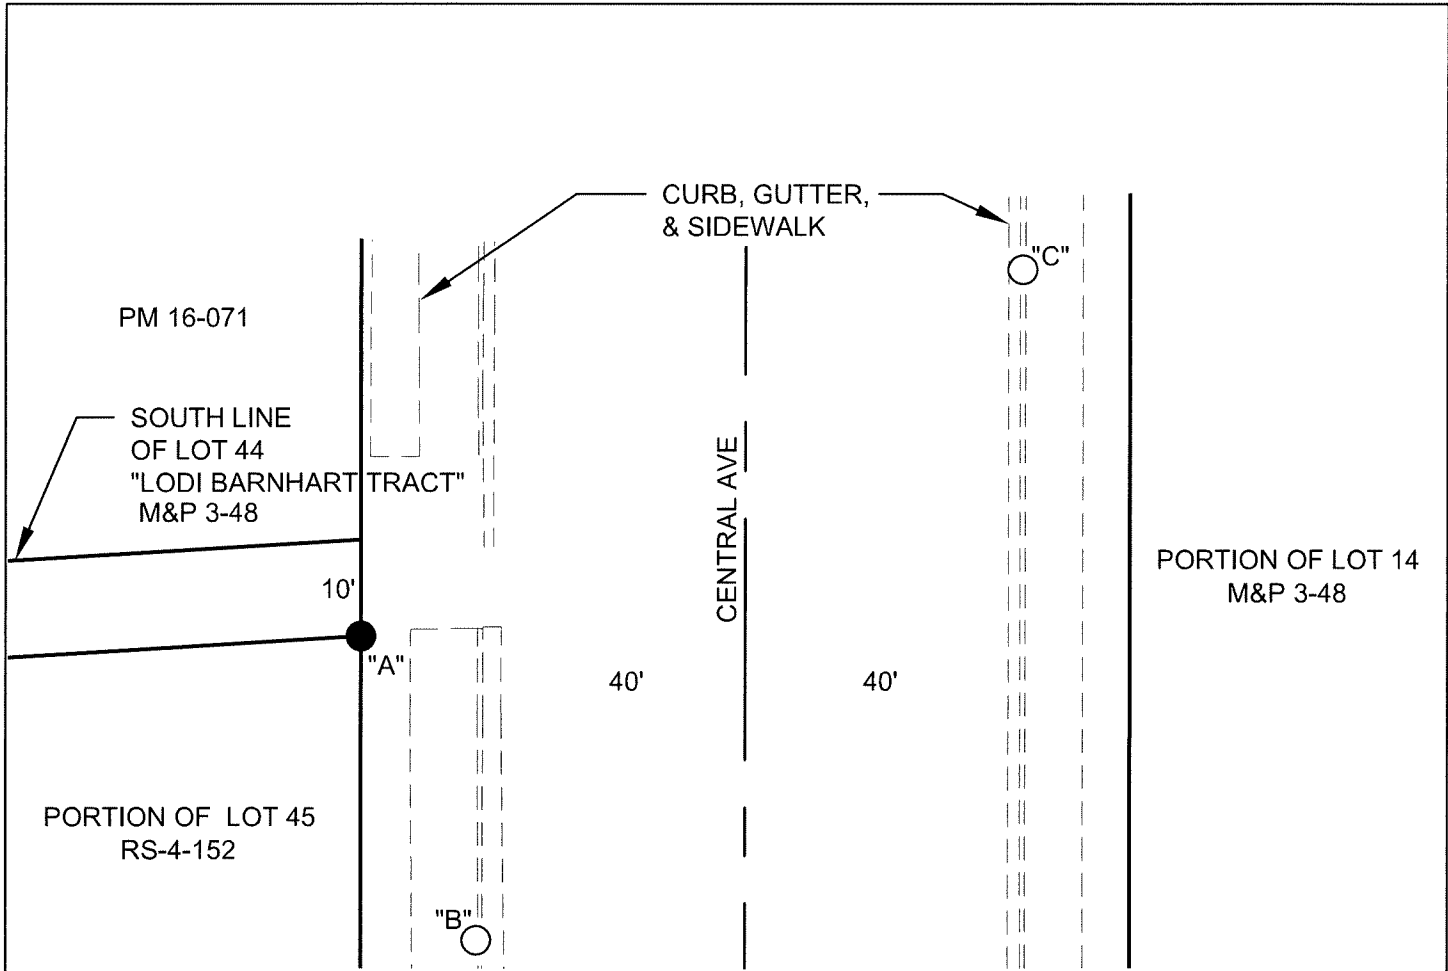

DISTANCE (M) TABLE					
FOUND MONUMENT	FROM	DIST	FROM2	DIST2	
"A"	1" AXLE (NT)	"B"	33.87'	"C"	78.58'

**LEGEND**

- FOUND MONUMENT PER RS 4-152, AS NOTED
- SET NAIL WITH WASHER STAMPED "C. O. L. LS 9478"
- RS RECORD OF SURVEY, BOOK & PAGE, SAN JOAQUIN COUNTY RECORDS
- M&P MAPS & PLATS, VOLUME & PAGE, SAN JOAQUIN COUNTY RECORDS
- PM PARCEL MAP, VOLUME & PAGE, SAN JOAQUIN COUNTY RECORDS
- DIST DISTANCE
- (M) MEASURED ON THIS SURVEY
- (NT) NO TAG

