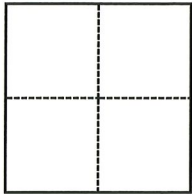


CORNER RECORD

Agency Index

CR-23-154

Document Number

City of Manteca County of San Joaquin, CaliforniaBrief Legal Description Southeast Corner Section 1, T.2S., R.6E., M.D.B. & M.**CORNER TYPE****COORDINATES (Optional)**

- ☒ Government Corner ☐ Control
☐ Meander ☐ Property
☐ Rancho ☐ Other

Date of Survey March 12, 2023

N. _____ E. _____

Elevation _____

Units ☐ Metric ☒ U.S. Survey Foot

Horizontal Datum _____

Zone _____ Epoch Date _____

Vertical Datum _____

☐ Complies with Public Resources Code §§8801-8819☐ Complies with Public Resources Code §§8890-8902

PLS Act Ref.:

☐ 8765(d)☒ 8771☐ 8773☐ Other:Corner/
Monument:☒ Left as found☐ Established☐ Rebuilt☐ Pre-Construction☐ Found and tagged☐ Reestablished☒ Referenced☒ Post-Construction

Narrative of corner identified and monument as found, set, reset, replaced, or removed:

☒ See sheet #2 for description(s):**SURVEYOR'S STATEMENT**

This Corner Record was prepared by me or under my direction in conformance with

the Professional Land Surveyors' Act on March 23, 2023

Signed

P.L.S. or R.C.E. No.

8159**COUNTY SURVEYOR'S STATEMENT**

This Corner Record was received

May 17, 2023

and examined and filed

May 30, 2023

Signed

P.L.S. or R.C.E. No.


8657

Title

County Surveyor

County Surveyor's Comment



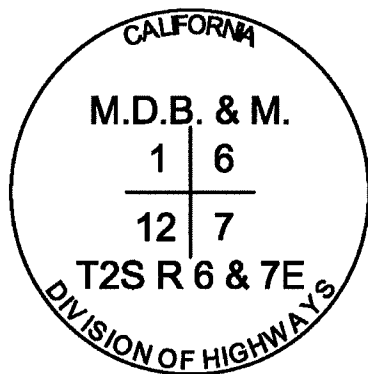

T.2S.,R.6E.
M.D.B. & M.



NOT TO SCALE

AIRPORT
WAY

CENTERLINE OF
AIRPORT WAY,
SECTION LINE &
RANGE LINE

CONCRETE
RIDGE
DECK

STATE
ROUTE 120

T.2S.,R.7E.
M.D.B. & M.

SEC. 1

SEC. 6

SEC. 12

SEC. 7

FOUND BRASS DISC IN
MONUMENT WELL
(PER 28-RS-129)
(PER CR-95-001)

-RS- RECORD OF SURVEY, SAN JOAQUIN COUNTY RECORDS
CR CORNER RECORD, SAN JOAQUIN COUNTY SURVEYOR'S RECORDS