


CORNER RECORD

Agency Index CR-23-177
Document Number _____

City of Lodi County of San Joaquin, California
Brief Legal Description _____ Parcel 1, P.M. 26-169, S.J.C.R.

CORNER TYPE

COORDINATES (Optional)

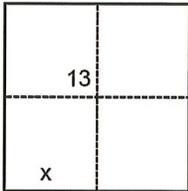

- Government Corner Control
 Meander Property
 Rancho Other

N. _____ E. _____
 Elevation _____
 Units Metric U.S. Survey Foot
 Horizontal Datum _____
 Zone _____ Epoch Date _____
 Vertical Datum _____
 Complies with Public Resources Code §§8801-8819
 Complies with Public Resources Code §§8890-8902

Date of Survey June 6, 2023

T.3N., R.6E., M.D.B.&M.

- PLS Act Ref.: 8765(d) 8771 8773 Other:
 Corner/
 Monument: Left as found Established Rebuilt Pre-Construction
 Found and tagged Reestablished Referenced Post-Construction

Narrative of corner identified and monument as found, set, reset, replaced, or removed:

See sheet #2 for description(s):

SURVEYOR'S STATEMENT

This Corner Record was prepared by me or under my direction in conformance with
 the Professional Land Surveyors' Act on July 6, 2023
 Signed Joe Murphy (P.L.S.) or R.C.E. No. 7269




COUNTY SURVEYOR'S STATEMENT

This Corner Record was received July 7, 2023
 and examined and filed July 13, 2023
 Signed James E. Hart P.L.S. or R.C.E. No. 8657
 Title County Surveyor



County Surveyor's Comment

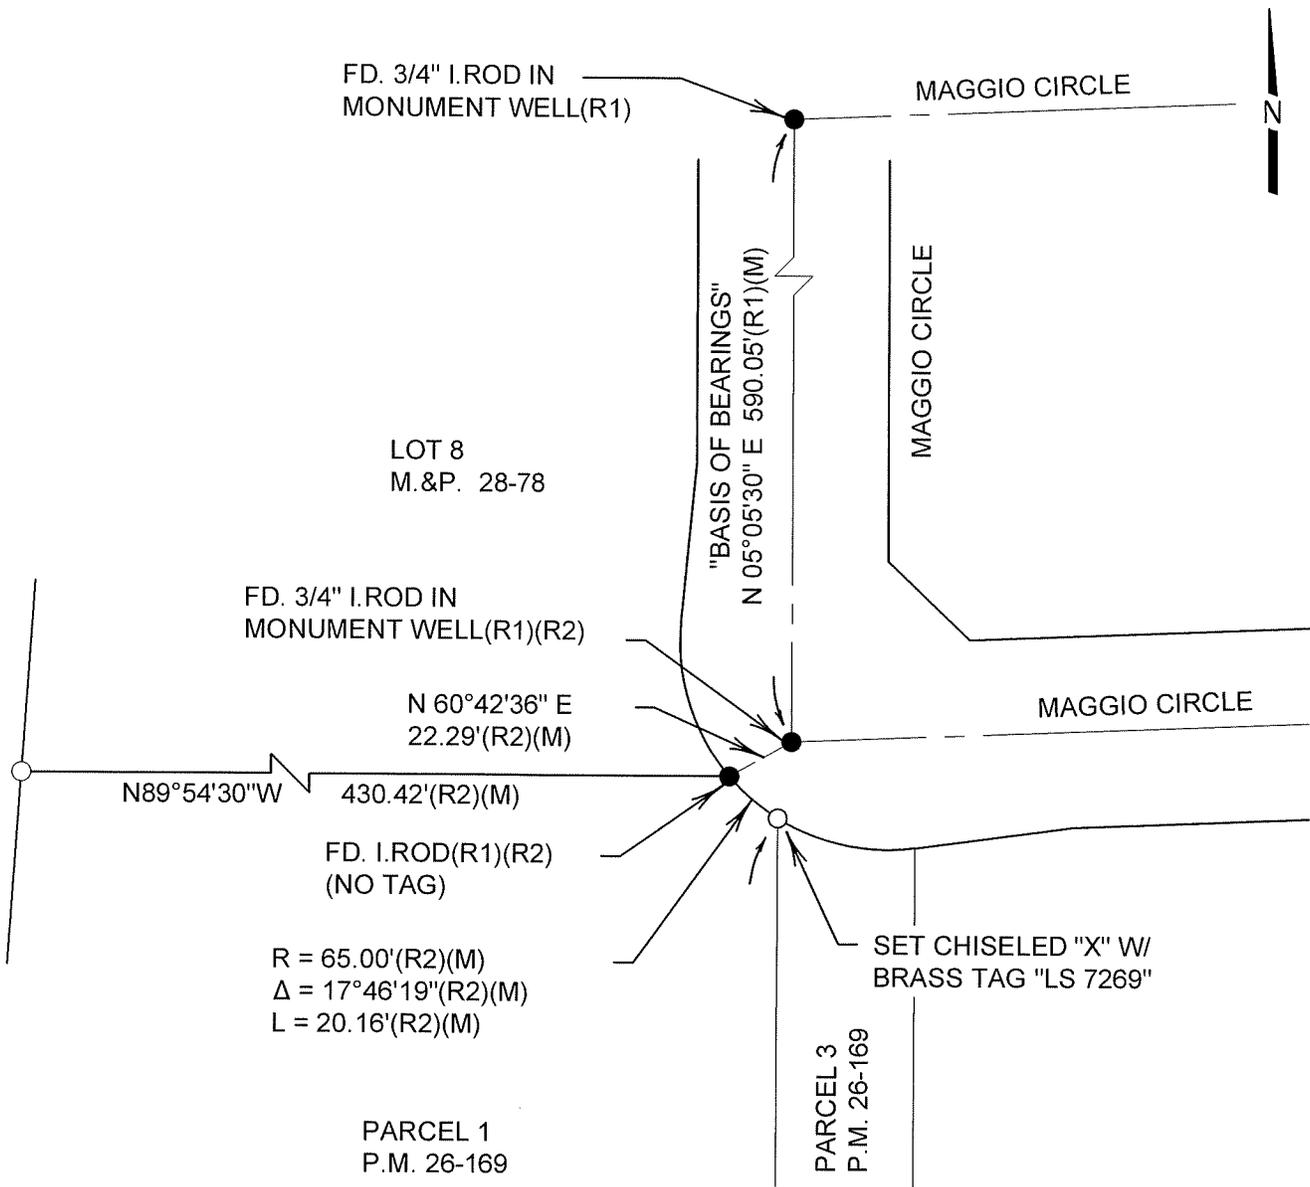

LEGEND

- | | |
|----------|--|
| S.J.C.R. | SAN JOAQUIN COUNTY RECORDS |
| ● | FOUND MONUMENT AS NOTED |
| ○ | SET 3/4" X 30" IRON ROD,
CAPPED L.S. 7269, UNLESS
OTHERWISE NOTED. |
| M.&P. | MAPS AND PLATS |
| P.M. | PARCEL MAP |
| FD. | FOUND |
| (M) | MEASURED |
| I. ROD | IRON ROD |

REFERENCES

- | | |
|------|-----------------------|
| (R1) | M.&P. 28-78, S.J.C.R. |
| (R2) | P.M. 26-169, S.J.C.R. |