

CORNER RECORD

Agency Index

CR-23-194

Document Number

City of STOCKTON

County of SAN JOAQUIN, California

Brief Legal Description LINE COMMON TO LOTS 568 AND 569 OF "LINCOLN VILLAGE WEST, UNIT NO. 10",
BOOK 19 OF MAPS AND PLATS, PAGE 21, S.J.C.R.



T.2N., R.6E.

CORNER TYPE

- ☐ Government Corner ☐ Control
☐ Meander ☒ Property
☐ Rancho ☐ Other

Date of Survey 4/21/2023

COORDINATES (Optional)

N. E.

Elevation

Units ☐ Metric ☐ U.S. Survey Foot

Horizontal Datum

Zone Epoch Date

Vertical Datum

☐ Complies with Public Resources Code §§8801-8819☐ Complies with Public Resources Code §§8890-8902PLS Act Ref: ☐ 8765(d)☒ 8771☐ 8773☐ Other:Corner/Monument: ☐ Left as found☐ Established☐ Rebuilt☐ Pre-Construction☐ Found and tagged ☒ Reestablished☐ Referenced☒ Post-Construction

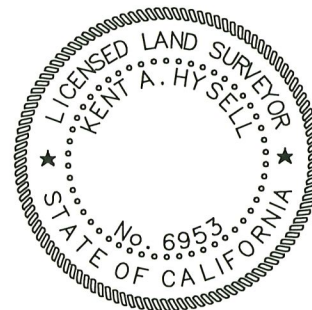
Narrative of corner identified and monument as found, set, reset, replaced, or removed:

☐ See sheet #2 for description (s):

FOUND FOUR (4) CONCRETE NAILS WITH BRASS TAG "LS 6953" AS WITNESS CORNERS (R1); SET ONE (1)
CONCRETE NAIL WITH BRASS TAG "LS 6953", ALL AS SHOWN ON SHEET 2.

SURVEYOR'S STATEMENT

This Corner Record was prepared by me or under my direction in conformance with
the Professional Land Surveyors' Act on AUGUST 7, 2023

Signed [Signature] P.L.S. or R.C.E. No. 6953

COUNTY SURVEYOR'S STATEMENT

This Corner Record was received August 10, 2023

and examined and filed August 11, 2023

Signed James E. Hart P.L.S. or R.C.E. No. 8657Title County Surveyor

County Surveyor's Comment

LEGEND:

SET CONCRETE NAIL WITH BRASS TAG "LS 6953".



FOUND CONCRETE NAIL WITH BRASS TAG "LS 6953".

-M&P-

MAPS & PLATS

C.R.

CORNER RECORD

S.J.C.R.

SAN JOAQUIN COUNTY RECORDS

S.J.C.S.R.

SAN JOAQUIN COUNTY SURVEYOR'S RECORDS

(M)

MEASURED DISTANCE. ALL DISTANCES ARE
MEASURED UNLESS NOTED OTHERWISE.**NOTE:**THIS CORNER RECORD DOES NOT VERIFY THIS
MONUMENT TO BE IN THE CORRECT POSITION.

4 AND DISTANCE TABLE

BS-@-FS	4	FS DISTANCE
C-A-C	00°00'00"	124.195'(M)(R1)
C-A-B	214°52'14"	49.308'(M)(R1)
C-A-D	249°45'06"	69.285'(M)(R1)
C-A-E	224°56'12"	138.035'(M)(R1)

REFERENCE:

(R1) C.R. 23-164, S.J.C.S.R.



SCALE: 1" = 30'

HERNDON PLACE

