

# CORNER RECORD


Agency Index: CR-23-207

Document Number: \_\_\_\_\_

City of STOCKTON

County of SAN JOAQUIN, California

Brief Legal Description MONUMENT AT THE INTERSECTION OF WAIT AVENUE AND HARVEY AVENUE

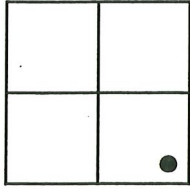

SECTION 11  
C.M. WEBER'S GRANT

### CORNER TYPE

- Government Corner
- Meander
- Rancho
- Control
- Property
- Other

Date of Survey 6-29-2023

### COORDINATES (Optional)

N. \_\_\_\_\_ E. \_\_\_\_\_

Elevation \_\_\_\_\_

Units  Metric  U.S. Survey Foot

Horizontal Datum \_\_\_\_\_

Zone \_\_\_\_\_ Epoch Date \_\_\_\_\_

Vertical Datum \_\_\_\_\_

Complies with Public Resources Code SS8801-8819

Complies with Public Resources Code SS8890-8902

PLS Act Ref:  8765(d)  8771  8773  Other:

Corner/Monument:  Left as found  Established  Rebuilt  Pre-Construction  
 Found and Tagged  Reestablished  Referenced  Post-Construction

Narrative of corner identified and monument as found, set, reset, replaced, or removed:

See sheet #2 for description(s):

FOUND THREE (3) CONCRETE NAILS WITH BRASS TAG "LS 6953" AS SHOWN ON THE CORNER RECORD FILED AS CR-23-140. SET (1) 3/4" IRON PIPE TAGGED "LS 6953" IN MONUMENT WELL, ALL AS SHOWN ON PAGE 2.

### SURVEYOR'S STATEMENT

This Corner Record was prepared by me or under my direction in conformance with the Land Surveyors' Act on AUGUST 25, 2023,  
 Signed [Signature] P.L.S. or R.C.E. Number 6953




### COUNTY SURVEYOR'S STATEMENT

This Corner Record was received September 14, 2023  
 and examined and filed September 28, 2023  
 Signed James E. Hart P.L.S. or R.C.E. No: 8657  
 Title County Surveyor



County Surveyor's Comment \_\_\_\_\_

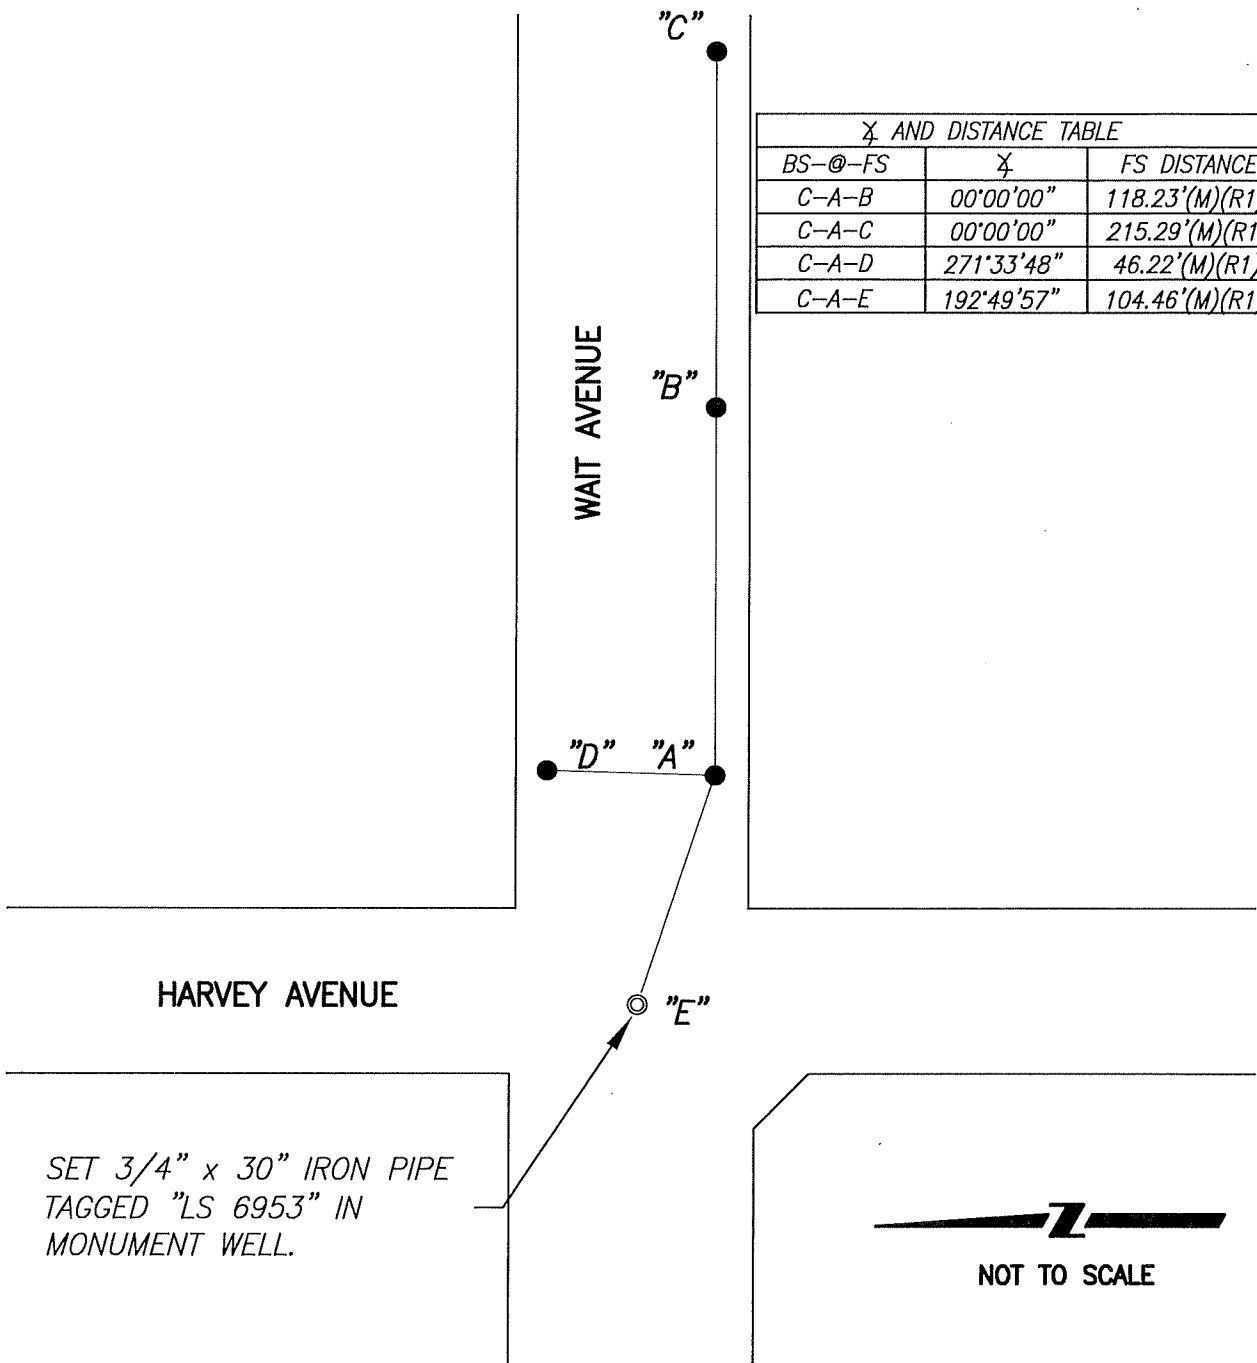

**LEGEND:**

- FOUND CONCRETE NAIL WITH BRASS TAG "L.S.6953" IN SIDEWALK.
- ⊙ SET MONUMENT AS NOTED.
- C.R. DENOTES CORNER RECORD, S.J.C.S.R.
- S.J.C.S.R. DENOTES SAN JOAQUIN COUNTY SURVEYOR'S RECORDS
- (M) MEASURED DISTANCE. ALL DISTANCES ARE MEASURED UNLESS NOTED OTHERWISE.

**REFERENCE:**

(R1) C.R. 23-140, S.J.C.S.R.