
CORNER RECORD				gency Index	CR-23-211		
001				Oocument Number			
City of				San Joaqui		_, California	
Brief Legal Des	cription Airport Wo						
		thin Sec. 27, C.M. W	Veber				
	C	ORNER TYPE			DINATES (Optional		
	Government Corr	ner Control		N Elevation.	Б		
	Meander	☐ Property		Units Met	ric U.S. Surve	y Foot X	
	 Rancho	Other	X	Horizontal Datum _			
				Zone			
	Date of Survey _	Date of Survey January 21, 2022			Vertical Datum  Complies with Public Resources Code §§8801-8819		
					c Resources Code § c Resources Code §		
PLS Act Ref.:	☐ 8765(d)	X 8771		8773	Other:	33000 0002	
Corner/ Monument:	X Left as found	Established		Rebuilt	X Pre-Cons		
	☐ Found and tagged ☐ Reestablished		ad	Referenced	☐ Post-Cor		
					CONAL	LANDS	
	SURVEYOR'S	STATEMENT			12/MES	L. /4072	
This Corner Record was prepared by me or under my direction in conform				nce with	ROA		
the Professional Land Surveyor's Act on January			)22			FNSF 7	
$\cap$				0/57	\ <b>★</b> \ No.	8657	
Signed	mes & Hart	P.L.S. or R.C.E. N	10	8657			
0					TE OF	CALIFOR	
	COUNTY SURVEY	OR'S STATEMENT			10	CALI	
This Corner Record	d was receivedAu	gust 30, 20	23				
and examined and		5,2023			SONAL	F	
$\bigcirc$	Z 14 x			8657	(12/M)	- 74p	
Signed	mes Z. Mail	P.L.S. <del>or R.C.E</del> . N	lo		ROY	1/2	
Title	County Surveyor					FNICE T	
County Surveyo	r's Comment				\\ <b>*</b> \ No.	8657 <b>★</b>	
					E OF	CALLEDY	

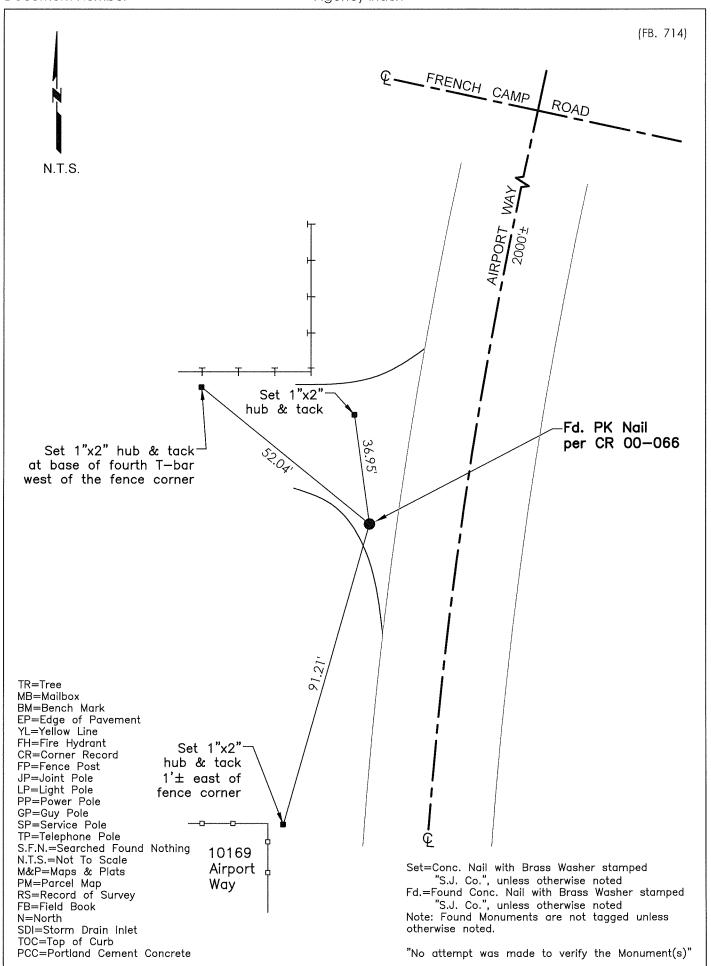

BPELSG-2016 Page 2 of 2