


CORNER RECORD

Agency Index CR-23-212
Document Number _____

City of _____ County of San Joaquin, California
Brief Legal Description Airport Way 2000' south of French Camp Road
Within Sec. 27, C.M. Weber Grant

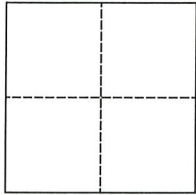

CORNER TYPE
Government Corner Control
Meander Property
Rancho Other

COORDINATES (Optional)
N. _____ E. _____
Elevation. _____
Units Metric U.S. Survey Foot
Horizontal Datum _____
Zone _____ Epoch Date _____
Vertical Datum _____
 Complies with Public Resources Code §§8801-8819
 Complies with Public Resources Code §§8890-8902

Date of Survey August 26, 2022

PLS Act Ref.: 8765(d) 8771 8773 Other:
Corner/Monument: Left as found Established Rebuilt Pre-Construction
 Found and tagged Reestablished Referenced Post-Construction

Narrative of corner identified and monument as found, set, reset, replaced, or removed:
 See sheet #2 for description(s):

SURVEYOR'S STATEMENT

This Corner Record was prepared by me or under my direction in conformance with
the Professional Land Surveyor's Act on October 28, 2022

Signed James E Hart P.L.S. or R.C.E. No. 8657



COUNTY SURVEYOR'S STATEMENT

This Corner Record was received August 30, 2023
and examined and filed October 5, 2023

Signed James E Hart P.L.S. or R.C.E. No. 8657
Title _____ County Surveyor


County Surveyor's Comment





FRENCH CAMP ROAD

AIRPORT WAY
2000'±

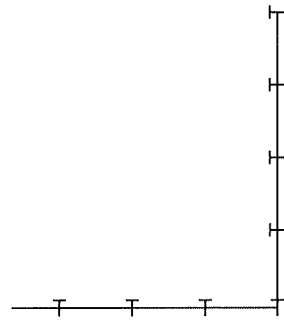

Fd. 1"x2" hub & tack

Fd. 1"x2" hub & tack at base of fourth T-bar west of the fence corner

52.04'

36.95'

PK Nail per CR gone. Set 3/4"x30" rebar with yellow cap stamped "SJ PUB WORKS". Placed monument box over monument.

91.21'

Fd. 1"x2" hub & tack 1'± east of fence corner

10169 Airport Way

- TR=Tree
- MB=Mailbox
- BM=Bench Mark
- EP=Edge of Pavement
- YL=Yellow Line
- FH=Fire Hydrant
- CR=Corner Record
- FP=Fence Post
- JP=Joint Pole
- LP=Light Pole
- PP=Power Pole
- GP=Guy Pole
- SP=Service Pole
- TP=Telephone Pole
- S.F.N.=Searched Found Nothing
- N.T.S.=Not To Scale
- M&P=Maps & Plats
- PM=Parcel Map
- RS=Record of Survey
- FB=Field Book
- N=North
- SDI=Storm Drain Inlet
- TOC=Top of Curb
- PCC=Portland Cement Concrete

Set=Conc. Nail with Brass Washer stamped "S.J. Co.", unless otherwise noted
 Fd.=Found Conc. Nail with Brass Washer stamped "S.J. Co.", unless otherwise noted
 Note: Found Monuments are not tagged unless otherwise noted.

"No attempt was made to verify the Monument(s)"