CORNER RECORD

Agency Index

					Document Number
 _	000000000	_		_	

City of	STOCKTON	County of _	SAN JOAQ	UIN , California				
Brief Legal Description LOT 5, BLOCK 239, EAST OF CENTER STREET								
	COI	CORNER TYPE		COORDINATES (Optional)				
	Government Meander Rancho Date of Survey	Corner Control X Property Other October 5, 2023	Vertical Datum Complies with Public F	Ch Date Resources Code §§8801-8819 Resources Code §§8890-8902				
PLS Act Ref.:	× 8765(d)	8771	8773	Other:				
Corner/ Monument:	Left as found Found and tagged	Established Reestablished	Rebuilt Referenced	Pre-Construction Post-Construction				
Narrative of corner ide ✓ See sheet #2 for	entified and monument as fo description(s):	ound, set, reset, replaced,	or removed:					

SURVEYOR'S STATEMENT

This Corner Record was prepared by me or under my direction in conformance with

the Professional Land Surveyors' Act on

Signed



COUNTY SURVEYOR'S STATEMENT

This Corner Record was received


and examined and filed

Signed

Title

County Surveyor's Comment



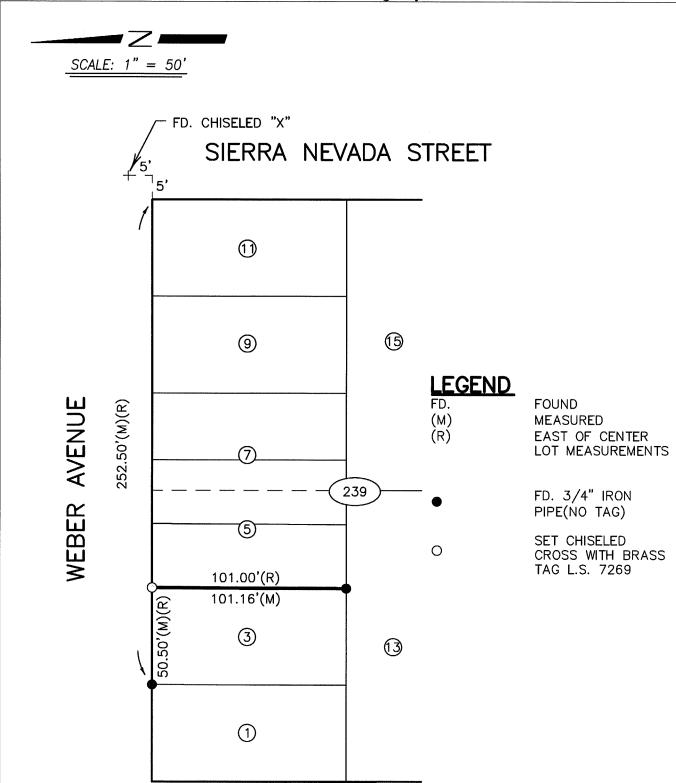

AIRPORT WAY