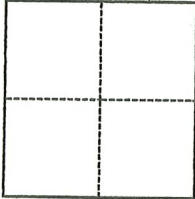


CORNER RECORD

Agency Index

CR-23-260

Document Number

City of STOCKTON County of SAN JOAQUIN, CaliforniaBrief Legal Description INTERSECTION OF EL DORADO STREET & FREMONT STREET**CORNER TYPE****COORDINATES (Optional)**

- | | |
|--|--|
| <input type="checkbox"/> Government Corner | <input type="checkbox"/> Control |
| <input type="checkbox"/> Meander | <input checked="" type="checkbox"/> Property |
| <input type="checkbox"/> Rancho | <input type="checkbox"/> Other |

Date of Survey October 30, 2023

N. _____ E. _____

Elevation _____

Units ☐ Metric ☐ U.S. Survey Foot

Horizontal Datum _____

Zone _____ Epoch Date _____

Vertical Datum _____

☐ Complies with Public Resources Code §§8801-8819☐ Complies with Public Resources Code §§8890-8902

PLS Act Ref.:

☒ 8765(d)☐ 8771☐ 8773☐ Other:Corner/
Monument:☒ Left as found☐ Established☐ Rebuilt☐ Pre-Construction☐ Found and tagged☒ Reestablished☐ Referenced☒ Post-Construction

Narrative of corner identified and monument as found, set, reset, replaced, or removed:

☒ See sheet #2 for description(s):

SEE PAGE 2 OF 2 FOR EXHIBIT MAP SHOWING CONTROL MONUMENTS FOUND PER CR 23-126, S.J.C.S.R., AND MONUMENTS REESTABLISHED.


SURVEYOR'S STATEMENT

This Corner Record was prepared by me or under my direction in conformance with

the Professional Land Surveyors' Act on October 30, 2023Signed Walter John Shoup P.L.S. or R.C.E. No. L-7736**COUNTY SURVEYOR'S STATEMENT**This Corner Record was received October 31, 2023and examined and filed November 16, 2023Signed James E. Hart P.L.S. or R.C.E. No. 8657Title County Surveyor

County Surveyor's Comment

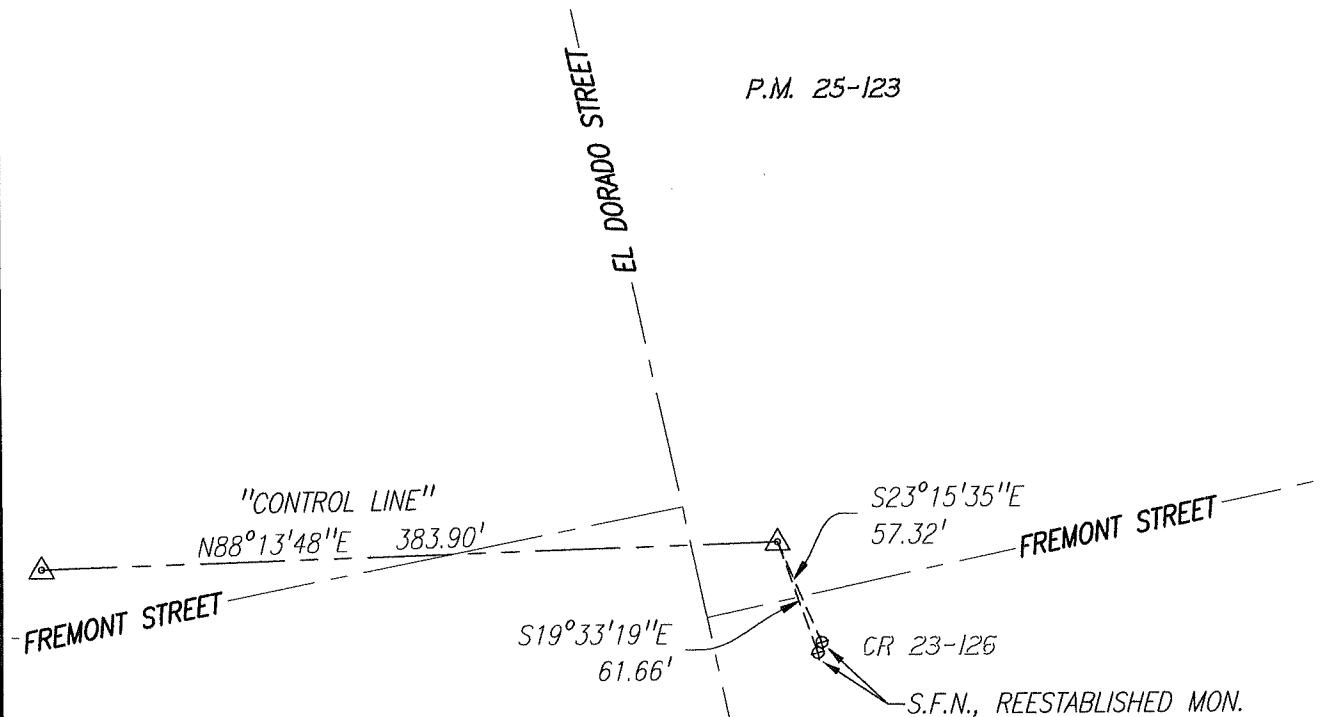

REFERENCE:

(R1) CR 23-126, S.J.C.S.R.

LEGEND:



FD. FOUND
 MON. MONUMENT
 P.M. PARCEL MAP, BOOK-PAGE, S.J.C.R.
 S.F.N. SEARCHED, FOUND NOTHING
 S.J.C.R. SAN JOAQUIN COUNTY RECORDS
 S.J.C.S.R. SAN JOAQUIN COUNTY SURVEYOR'S RECORDS
 CR CORNER RECORD, S.J.C.S.R.

MONUMENTS FOUND AND SET:

- △— FD. MAG & WASHER STAMPED "SLS CONTROL-PLS 7736" PER (R1)
 —○— SET 1.25" COPPERWELD DISK STAMPED "PLS 7736"

NOTE:

"NO ATTEMPT WAS MADE TO VERIFY THE MONUMENT(S)".

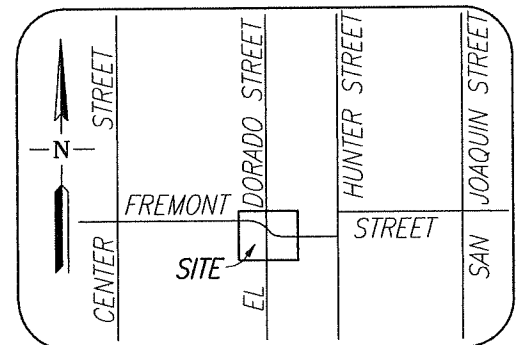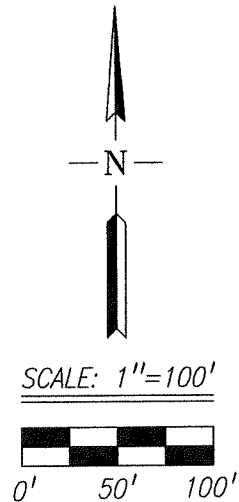

VICINITY MAP
 NO SCALE

Scale: 1"=100'
 Job No.: 23-010

CORNER RECORD
EXHIBIT MAP

Date: 10/30/2023
 DWG: 23010CR-POST