


# CORNER RECORD

Agency Index CR-23-263  
 Document Number \_\_\_\_\_

City of \_\_\_\_\_ County of SAN JOAQUIN, California  
 Brief Legal Description PARCEL D, P.M. 4-168, S.J.C.R.

**CORNER TYPE**

**COORDINATES (Optional)**

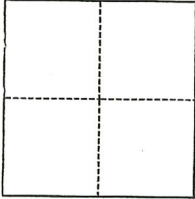

- Government Corner
- Meander
- Rancho
- Control
- Property
- Other

N. \_\_\_\_\_ E. \_\_\_\_\_  
 Elevation \_\_\_\_\_  
 Units  Metric  U.S. Survey Foot  
 Horizontal Datum \_\_\_\_\_  
 Zone \_\_\_\_\_ Epoch Date \_\_\_\_\_  
 Vertical Datum \_\_\_\_\_  
 Complies with Public Resources Code §§8801-8819  
 Complies with Public Resources Code §§8890-8902

Date of Survey November 2, 2023

- PLS Act Ref.:  8765(d)  8771  8773  Other: \_\_\_\_\_
- Corner/Monument:  Left as found  Established  Rebuilt  Pre-Construction  
 Found and tagged  Reestablished  Referenced  Post-Construction

Narrative of corner identified and monument as found, set, reset, replaced, or removed:  
 See sheet #2 for description(s):

SEE SHEET 2 OF 2 FOR MONUMENTS FOUND.

**SURVEYOR'S STATEMENT**

This Corner Record was prepared by me or under my direction in conformance with  
 the Professional Land Surveyors' Act on 11/03/2023  
 Signed Walter John Shoup P.L.S. or R.C.E. No. L-7736



**COUNTY SURVEYOR'S STATEMENT**


This Corner Record was received November 9, 2023  
 and examined and filed November 30, 2023  
 Signed James E. Hart P.L.S. or R.C.E. No. 8657  
 Title County Surveyor



**County Surveyor's Comment**

**LEGEND:**  
 COR. CORNER  
 D.N. DOCUMENT NUMBER, S.J.C.R.  
 FD. FOUND  
 MON. MONUMENT  
 P.M. PARCEL MAP, BOOK-PAGE, S.J.C.R.  
 S.J.C.R. SAN JOAQUIN COUNTY RECORDS

**MONUMENTS FOUND:**  
 FD. 5/8" REBAR, NO TAG FOUND, DOWN 0.5'  
 [3/4" IRON ROD WITH BRASS TAG STAMPED "RCE 12665" PER (R1)]

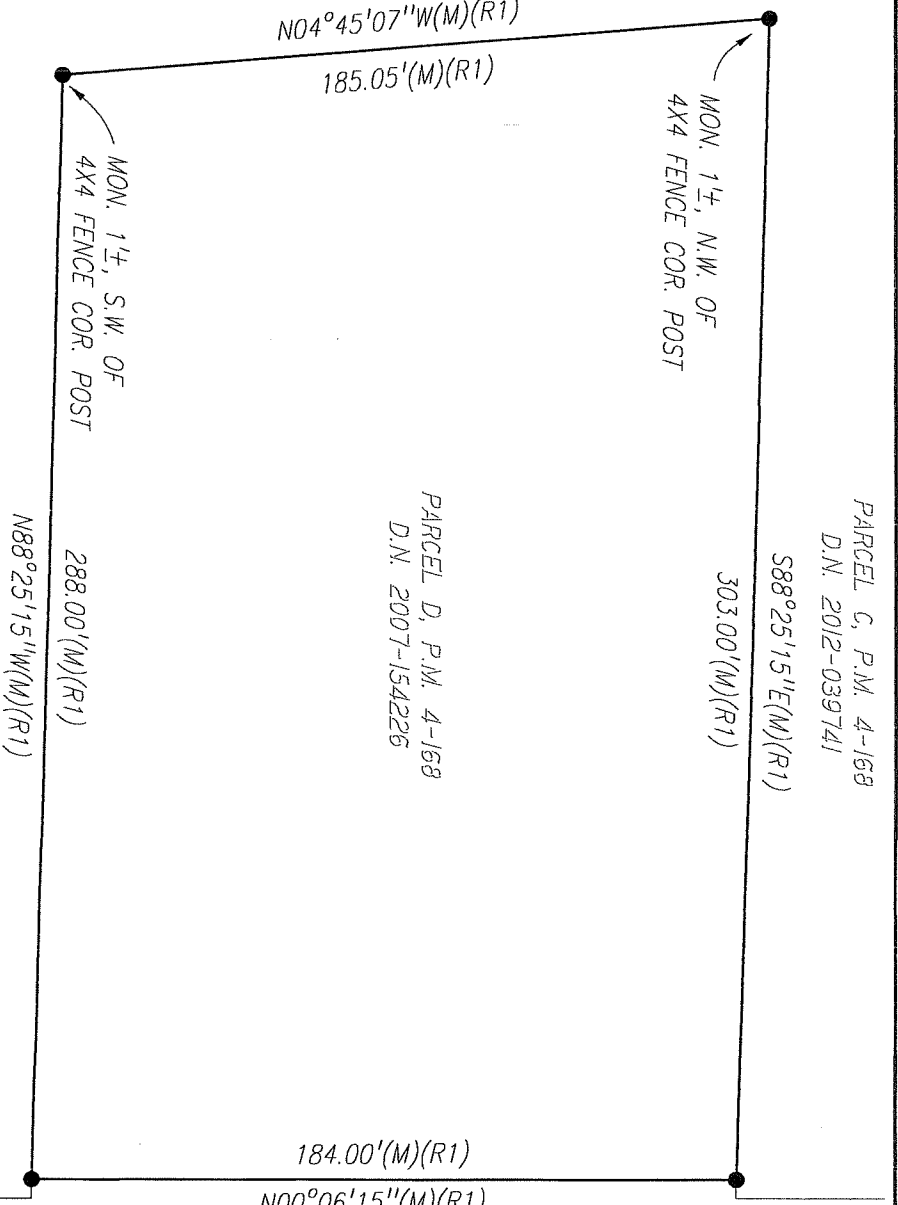

PARCEL C, P.M. 4-168  
 D.N. 2012-039741

S88°25'15"E(M)(R1)  
 303.00'(M)(R1)

PARCEL D, P.M. 4-168  
 D.N. 2007-154226



288.00'(M)(R1)  
 N88°25'15"W(M)(R1)

184.00'(M)(R1)  
 N00°06'15''(M)(R1)


RAY ROAD

25'  
 25'

30'  
 25'

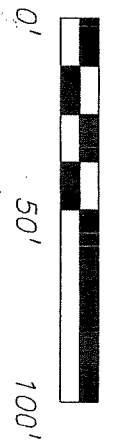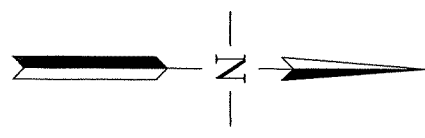

SCALE: 1"=50'

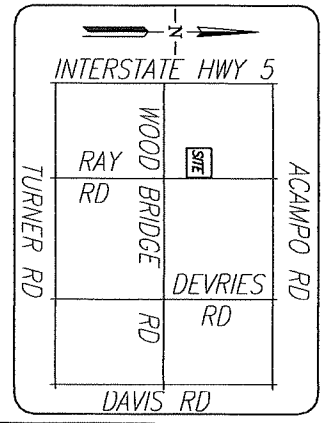

Scale: 1"=50'	<b>CORNER RECORD</b> EXHIBIT MAP	Date: 11/03/2023
Job No.: 23-158		DWG: 23158CR.DWG