| CORNER RECORD | Agency Index Document Number | UR-23-266 |
|--|--|--|
| Brief Legal Description Found chiseled "X"s as sho of Parcel Maps, at Page 19, S | own on that certain "P. | ARCEL MAP" filed in Book 12 |
| CORNER TYP | N | COORDINATES (Optional) |
| Government Corner Control Meander Propert Rancho Other | ty Units Units Horizontal Datur | Metric ☐ U.S. Survey Foot ☒ m Epoch Date |
| Date of Survey 10/27/2022 SECTION 4, T.1N., R.6E., M.D.B.&M. | Complies with Pu | ublic Resources Code §§8801-8819 ublic Resources Code §§8890-8902 |
| PLS Act Ref: ☐ 8765(d) ☐ 8771 | □ 8773 | Other: |
| Corner/ | Rebuilt Referenced | ☑ Pre-Construction☐ Post-Construction |
| Narrative of corner identified and monument as found, set, re See sheet #2 for description (s): REFERENCED THREE CHISELED "X"s FOUND PER MONUMENTS REFERENCED PER PLS ACT 8771 S | 12 PM 19. | d: SED LAND SUR SUR SUR SUR SUR SUR SUR SUR |
| SURVEYOR'S STATEMENT | | No. 7228 |
| This Corner Record was prepared by me or under my direction the Professional Land Surveyors' Act on P.L.S. No | 023 | ONAL LAND CO |
| COUNTY SURVEYOR'S STATEMENT This Corner Record was received November 17, 2 and examined and filed December 4, 2023 Signed Surveyor P.L.S. or F. Title County Surveyor County Surveyor | 2023 R.C.E. No. 8657 | LICENSE No. 8657 |
| County ourveyor a Comment | | |

1914 MICHIGAN

AVENUE

Stockton\CiVIL3D\V-CORNER RECORD- Oxford &

SCALE: 1"=100"

STATEMENT OF PURPOSE:

THE PURPOSE OF THIS SURVEY IS TO IDENTIFY AND RECORD THE LOCATION OF EXISTING MONUMENTS PRIOR TO THE CONSTRUCTION OF PG&E FACILITIES AROUND THE MONUMENTS. THE PURPOSE OF THIS SURVEY IS NOT TO MAKE PROPERTY LINE DETERMINATION. LOT LINES SHOWN HEREON ARE FOR GENERAL LOCATION AND INFORMATIONAL PURPOSES ONLY.

LEGEND

X FOUND CHISELED "X"s PER 12-PM-19

X SET TAG AND WASHER TAGGED LS 7228




Nov/10/2023 8:33 AM | By: Tim.schoos:

BPELSG-2016



L1969 | 53.13, 68.12, 61.35 | 68.12,

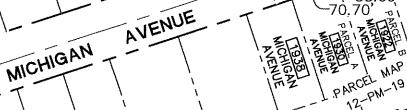



BRISTOL - AVENUE

Page 2 of 2