
## CORNER RECORD

CR-23-267 Agency Index Document Number County of SAN JOAQUIN City of STOCKTON , California Brief Legal Description MONUMENT WELL AT THE SOUTHWESTERLY CURB RETURN N. PILGRIM STREET AND E. HARDING WAY **CORNER TYPE COORDINATES (Optional)** E.\_\_\_\_ Government Corner Control Elevation U.S. Survey Foot Meander Property Units Metric Other Rancho Horizontal Datum Zone Epoch Date \_\_\_\_ Date of Survey SEPTEMBER 5, 2023 Vertical Datum Complies with Public Resources Code §§8801-8819 Complies with Public Resources Code §§8890-8902 8765(d) 8771 8773 Other: PLS Act Ref .: Left as found Established Rebuilt Pre-Construction Corner/ Monument: Found and tagged Reestablished Referenced Post-Construction Narrative of corner identified and monument as found, set, reset, replaced, or removed: See sheet #2 for description(s): FOUND 1-1/2" IRON PIN, NO PUNCH IN MONUMENT WELL LOCATED APPROXIMATELY 5' ± EASTERLY OF THE SOUTHWESTERLY CURB RETURN OF NORTH PILGRIM STREET AND EAST HARDING WAY (FORMERLY NORTH STREET). NO REFERENCE. MONUMENT WAS REFERENCED PRIOR TO THE START OF CONSTRUCTION OF A WATER MAIN REPLACEMENT, PROJECT NO. STK-18AM2 BY CALIFORNIA WATER SERVICE. SURVEYOR'S STATEMENT This Corner Record was prepared by me or under my direction in conformance with the Professional Land Surveyors' Act on SEPTEMBER 6, 2023 P.L.S. or R.C.E. No. 9251 Signed COUNTY SURVEYOR'S STATEMENT Jovember 22, 202 This Corner Record was received and examined and filed P.L.S. <del>or R.C.E</del>. No. 8657 Signed Title County Surveyor's Comment

Page 1 of 2



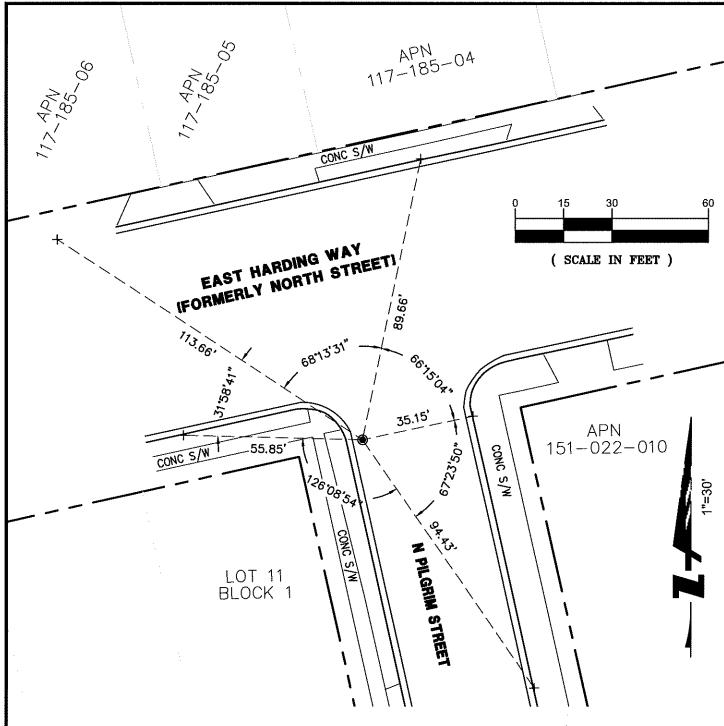

## **LEGEND**

- FOUND 1-1/2" IRON BAR, NO PUNCH IN MONUMENT WELL, NO REFERENCE.
- × SET MAG WITH WASHER ON CONCRETE CURB UNLESS OTHERWISE NOTED.

LOT — DENOTES THE LOT AND BLOCK AS SHOWN ON "MAP OF THE OAKS" IN BOOK OF BLOCK — MAPS, VOL. 5 AT PAGE 3, SAN JOAQUIN COUNTY RECORDS.

