
				12 22 21 9
CORNE	R RECORD		Agency Index _	CR-23-269
			Document Number _	
City of STOCKTO				, California
Brief Legal Descripti	on MONUMENT WELL AT STREET	THE NORTHERL	Y CURB RETURN N. PI	ILGRIM STREET AND E. ACACIA
CORNER TYPE			COORDINATES (Optional)	
		П о	N Elevation	E
	Government Corner Meander	Control Property	Units Metric	U.S. Survey Foot
ļ	=	=	2 1 -	0.3. Survey Pool
	Rancho	Other	Horizontal Datum	och Date
	Date of Survey SEPT	EMBER 2 2023	Vertical Datum	
	, <u>oli i</u>			Resources Code §§8801-8819
			Complies with Public Resources Code §§8890-8902	
PLS Act Ref.:	8765(d)	8771	8773	Other:
Corner/	Left as found	Established	Rebuilt	Pre-Construction
Monument:	Found and tagged	Reestablished	Referenced	Post-Construction
FOUND 1-1/2" IRON BAR, NO PUNCH IN MONUMENT WELL LOCATED APPROXIMATELY 5' ± EASTERLY OF THE NORTHERLY CURB RETURN OF N. PILGRIM STREET AND E. ACACIA STREET. NO REFERENCE. MONUMENT WAS REFERENCED PRIOR TO THE START OF CONSTRUCTION OF A WATER MAIN REPLACEMENT, PROJECT NO. STK-18AM2 BY CALIFORNIA WATER SERVICE. SURVEYOR'S STATEMENT				
CONAL LAND				
This Corner Record was prepared by me or under my direction in conformance with				
the Professional Land Surveyors' Act on SEPTEMBER 5, 2023				
Signed P.L.S. or R.C.E. No. 9251				
COUNTY SURVEYOR'S STATEMENT				
This Corner Record was and examined and filed Signed Title County Surveyor's C	December ≥ Hart P nty Surveyor	- 22, 202 2-5, 202 L.S. or R.C.E . No.	23	LICENSE No. 8657

Page 1 of 2

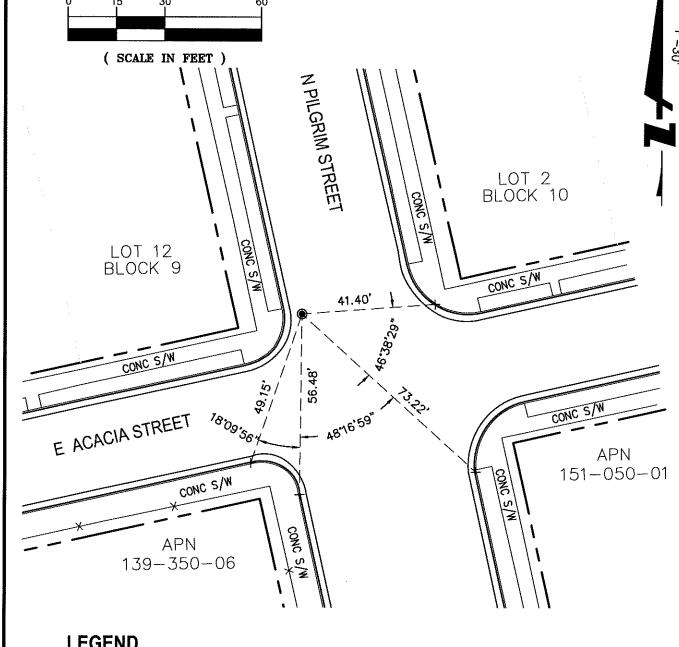

LEGEND

- FOUND 1-1/2" IRON PIN, NO PUNCH IN MONUMENT WELL, NO REFERENCE.
- SET MAG WITH WASHER ON CONCRETE CURB UNLESS OTHERWISE NOTED.

:LOT — DENOTES THE LOT AND BLOCK AS SHOWN ON "MAP OF THE OAKS" IN BOOK OF BLOCK ___ MAPS, VOL. 5 AT PAGE 3, SAN JOAQUIN COUNTY RECORDS.

SUBJECT PRE-CONSTRUCTION CORNER RECORD
AT THE INTERSECTION OF N PILGRIM STREET AND AT THE INTERSECT.....

E ACACIA STREET

JOB NO. 20191483—STOCKTON MON PRESERVATION

RY CCB APPR. BHS DATE 09-05-2023