
<b>CORNER RECORD</b>			P	Agency Index	CR-24-027		
				Document Number			
		County	0 ))		in	, California	
Brief Legal Des	cription <u>Wigwam D</u>						
		on 42, C.M. Webe	er Gran	nt			
CORNER TYPE				COORDINATES (Optional)			
I	Government Corne	er  Control		N Elevation.	E		
	Meander	Property		A CONTRACT OF STREET	tric U.S. Su	rvey Foot X	
	Rancho	☐ Other	X				
İ	Transite in the second						
	Date of Survey _/	Date of Survey May 1, 2023			Vertical Datum		
				Complies with Publi			
				Complies with Publi	ic Resources Cod	e §§8890-8902	
PLS Act Ref.:	8765(d)	X 8771		8773	☐ Other	:	
Corner/ Monument:	∠ Left as found	☐ Established		[ ] Rebuilt	☐ Pre-C	onstruction	
	☐ Found and tagged	Reestablish	ned	Referenced	X Post-0	Construction	
					SIONA	LLAND SCA	
	SURVEYOR'S	STATEMENT			//2/ RO	BERT L.	
This Corner Record was prepared by me or under my direction in confor				nce with		BERT L.	
the Professional Land Surveyor's Action July 28, 2023					[[-	72	
O O O I V							
1.2.0.011.0.2.110.						/ \ \ \ / /	
	)				(FO	FCALIFOR	
	COUNTY SURVEY	OR'S STATEMENT				TURE	
This Corner Record	d was received <u>Dece</u>	ember 27,	202	3	NA	LLAND	
and examined and	filed ()anuar	y 12 202	4		(5)0M	E. W.Scall	
Signed	min & Aux	P.L.S. or R.C.E.	No.	8657	The American	AP Z	
Signed	County Sun over	F.L.O. UFA C.E.	110		180 100 100 100 100 100 100 100 100 100	10	
Title	County Surveyor				( L	ICENSE   ]	
County Surveyo	or's Comment				No No	o. 8657	
					11/2/		
					WE O	FCALIFO	

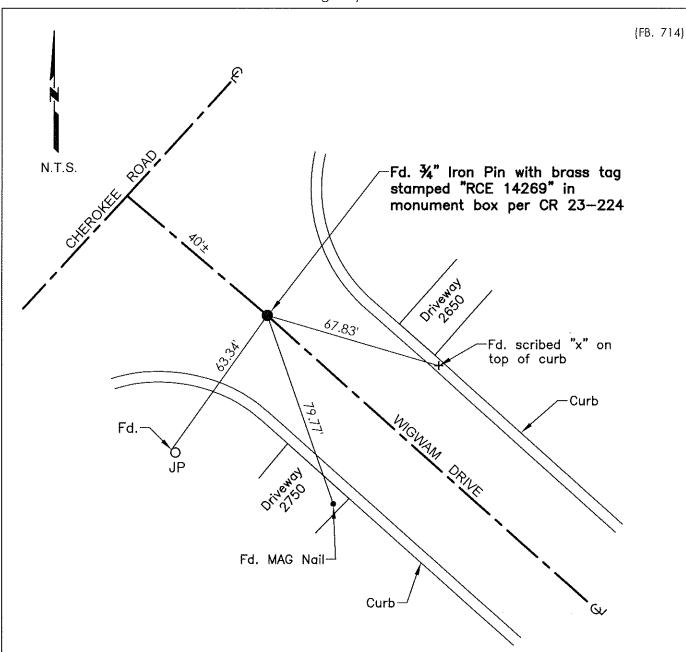

TR=Tree MB=Mailbox BM=Bench Mark EP=Edge of Pavement YL=Yellow Line FH=Fire Hydrant CR=Corner Record FP=Fence Post JP=Joint Pole LP=Light Pole PP=Power Pole GP≔Guy Pole SP=Service Pole TP=Telephone Pole S.F.N.=Searched Found Nothing N.T.S.=Not To Scale M&P=Maps & Plats PM≔Parcel Map RS=Record of Survey FB=Field Book N≔North SDI=Storm Drain Inlet TOC=Top of Curb PCC=Portland Cement Concrete

Set=Conc. Nail with Brass Washer stamped
"S.J. Co.", unless otherwise noted
Fd.=Found Conc. Nail with Brass Washer stamped
"S.J. Co.", unless otherwise noted
Note: Found Monuments are not tagged unless otherwise noted.

"No attempt was made to verify the Monument(s)"