Agency Index CR-24-067 CORNER RECORD Document Number SAN JOAQUIN California City of STOCKTON County of Brief Legal Description WITHIN E CHESTNUT ST AND N CALIFORNIA ST INTERSECTION **CORNER TYPE COORDINATES (Optional)** E. Elevation Government Corner Control U.S. Survey Foot Property Units Metric Meander Other Rancho Horizontal Datum **Epoch Date** Zone Date of Survey 10/21/2023 Vertical Datum Complies with Public Resources Code §§8801-8819 Complies with Public Resources Code §§8890-8902 Other: 8771 8773 8765(d) PLS Act Ref.: Rebuilt X Pre-Construction Established X Left as found Corner/ Monument: Referenced Post-Construction Found and tagged Reestablished Narrative of corner identified and monument as found, set, reset, replaced, or removed: See sheet #2 for description(s):

FOUND 3/4 INCH IRON PIN WITH TAP RCE 21447 WITHIN THE INTERSECTION OF EAST CHESTNUT STREET AND NORTH CALIFORNIA STREET. SET FOUR CUT "X" AS STRADDLERS FOR FOUND MONUMENT SHOWN ON SHEET 2. NO PREVIOUS 8771b CORNER RECORD ON FILE. CONTRACT MON #1054.

SURVEYOR'S STATEMENT

COUNTY SURVEYOR'S STATEMENT

This Corner Record was received <u>January</u> 22, 2024

and examined and filed <u>February</u> 8, 2024.

Signed <u>James E Haut</u> P.L.S. or R.G.E. No. 8657

Title <u>County Surveyor</u>

County Surveyor's Comment



PLS 5650


CAL


LEGEND

- FOUND 3/4 IN IRON PIN WITH TAG RCE 21447
- SET CUT "X" ON CONCRETE SIDEWALK UNLESS OTHERWISE SPECIFIED
- MANHOLE

— — — LOT LINE

(M) MEASURED ON THIS SURVEY

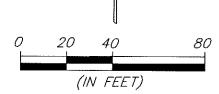

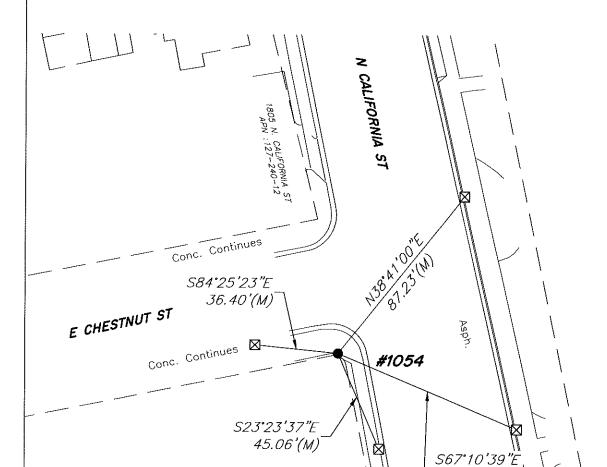

APN :127-180-49

84.09'(M)

MHO