


# CORNER RECORD

Agency Index CR-24-069  
 Document Number \_\_\_\_\_

City of STOCKTON County of SAN JOAQUIN, California  
 Brief Legal Description WITHIN E PINE ST AND N CALIFORNIA ST INTERSECTION

### CORNER TYPE

### COORDINATES (Optional)

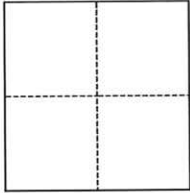

- Government Corner     Control  
 Meander                     Property  
 Rancho                          Other

Date of Survey 10/21/2023

N. \_\_\_\_\_ E. \_\_\_\_\_  
 Elevation \_\_\_\_\_  
 Units     Metric             U.S. Survey Foot  
 Horizontal Datum \_\_\_\_\_  
 Zone \_\_\_\_\_ Epoch Date \_\_\_\_\_  
 Vertical Datum \_\_\_\_\_  
 Complies with Public Resources Code §§8801-8819  
 Complies with Public Resources Code §§8890-8902

- PLS Act Ref.:     8765(d)             8771             8773             Other:  
 Corner/  
 Monument:     Left as found             Established             Rebuilt             Pre-Construction  
                    Found and tagged             Reestablished             Referenced             Post-Construction

Narrative of corner identified and monument as found, set, reset, replaced, or removed:  
 See sheet #2 for description(s):

*FOUND CUT "X" ON CONCRETE HANDICAP RAMP WITHIN THE INTERSECTION OF EAST PINE STREET AND NORTH CALIFORNIA STREET. SET FOUR CUT "X" AS STRADDLERS FOR FOUND MONUMENT SHOWN ON SHEET 2. NO PREVIOUS 8771B CORNER RECORD ON FILE. CONTRACT MON #1056.*

### SURVEYOR'S STATEMENT

This Corner Record was prepared by me or under my direction in conformance with the Professional Land Surveyors' Act on JANUARY 12, 2024.  
 Signed Carl L. Betz P.L.S. or R.C.E. No. LS 5650



### COUNTY SURVEYOR'S STATEMENT


This Corner Record was received January 22, 2024  
 and examined and filed February 8, 2024.  
 Signed James E. Hart P.L.S. or R.C.E. No. 8657  
 Title County Surveyor



County Surveyor's Comment

# LEGEND

- FOUND CUT "X" ON CONCRETE HANDICAP RAMP
- SET CUT "X" ON TOP OF CURB UNLESS OTHERWISE SPECIFIED
- TREE WELL
- MANHOLE
- GATE POST

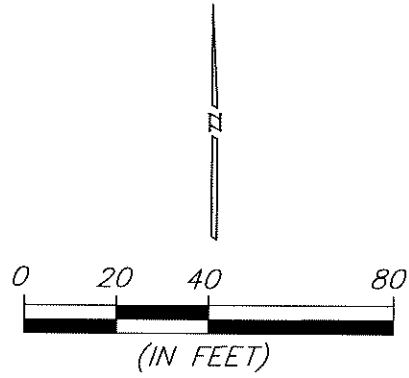

--- LOT LINE

○ ○ ○ ○ ○

(M) MEASURED ON THIS SURVEY

