

CORNER RECORD

Agency Index CR-24-080


Document Number _____

City of STOCKTON County of SAN JOAQUIN, California

Brief Legal Description WITHIN E WASHINGTON ST AND S CALIFORNIA ST INTERSECTION

CORNER TYPE

COORDINATES (Optional)

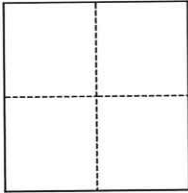

- Government Corner
- Meander
- Rancho
- Control
- Property
- Other

Date of Survey 11/17/2023

N. _____ E. _____

Elevation _____

Units Metric U.S. Survey Foot

Horizontal Datum _____

Zone _____ Epoch Date _____

Vertical Datum _____

Complies with Public Resources Code §§8801-8819

Complies with Public Resources Code §§8890-8902

PLS Act Ref.: 8765(d) 8771 8773 Other:

Corner/Monument: Left as found Established Rebuilt Pre-Construction

Found and tagged Reestablished Referenced Post-Construction

Narrative of corner identified and monument as found, set, reset, replaced, or removed:

See sheet #2 for description(s):

FOUND MAG NAIL AND WASHER IN CONCRETE WITHIN THE INTERSECTION OF EAST WASHINGTON STREET AND SOUTH CALIFORNIA STREET. SET FOUR CUT "X" AS STRADDLERS FOR FOUND MONUMENT SHOWN ON SHEET 2. NO PREVIOUS 8771B CORNER RECORD ON FILE. CONTRACT MON #1024.

SURVEYOR'S STATEMENT

This Corner Record was prepared by me or under my direction in conformance with the Professional Land Surveyors' Act on JANUARY 12, 2024.

Signed Carl L. Betz P.L.S. or R.C.E. No. LS 5650



COUNTY SURVEYOR'S STATEMENT

This Corner Record was received January 22, 2024

and examined and filed February 8, 2024.

Signed James E. Hart P.L.S. or R.C.E. No. 8657


Title County Surveyor

County Surveyor's Comment _____



LEGEND

- ⊙ FOUND MAG NAIL AND WASHER IN CONCRETE
- ⊠ SET CUT "X" ON CONCRETE SIDEWALK UNLESS OTHERWISE SPECIFIED
- TW TREE WELL
- MH MANHOLE
- GATE POST

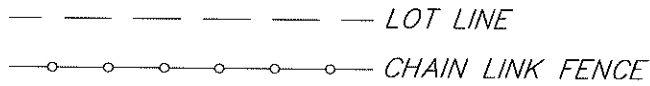

(M) MEASURED ON THIS SURVEY

