


CORNER RECORD

Agency Index CR-24-093
Document Number _____

City of STOCKTON County of SAN JOAQUIN, California
Brief Legal Description WITHIN E 5TH ST AND S CALIFORNIA ST INTERSECTION

CORNER TYPE

COORDINATES (Optional)

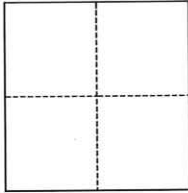

- Government Corner
- Meander
- Rancho
- Control
- Property
- Other

Date of Survey 12/02/2023

N. _____ E. _____
 Elevation _____
 Units Metric U.S. Survey Foot
 Horizontal Datum _____
 Zone _____ Epoch Date _____
 Vertical Datum _____
 Complies with Public Resources Code §§8801-8819
 Complies with Public Resources Code §§8890-8902

PLS Act Ref.: 8765(d) 8771 8773 Other:
 Corner/Monument: Left as found Established Rebuilt Pre-Construction
 Found and tagged Reestablished Referenced Post-Construction

Narrative of corner identified and monument as found, set, reset, replaced, or removed:
 See sheet #2 for description(s):

FOUND CUT "X" ON CONCRETE HANDICAP RAMP WITHIN THE INTERSECTION OF EAST 5TH STREET AND SOUTH CALIFORNIA STREET. SET FOUR CUT "X" AS STRADDLERS FOR FOUND MONUMENT SHOWN ON SHEET 2. NO PREVIOUS 8771b CORNER RECORD ON FILE. CONTRACT MON #1005.

SURVEYOR'S STATEMENT

This Corner Record was prepared by me or under my direction in conformance with the Professional Land Surveyors' Act on JANUARY 12, 2024
 Signed Carl L. Betz P.L.S. or R.C.E. No. LS 5650








COUNTY SURVEYOR'S STATEMENT


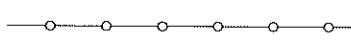
This Corner Record was received January 23, 2024
 and examined and filed February 8, 2024
 Signed James E. Hart P.L.S. or R.C.E. No. 8657
 Title County Surveyor



County Surveyor's Comment

LEGEND

-  FOUND CUT "X" ON CONCRETE HANDICAP RAMP
-  SET CUT "X" ON CONCRETE SIDEWALK UNLESS OTHERWISE SPECIFIED
-  TREE WELL
-  MANHOLE
-  GATE POST

-  LOT LINE
-  CHAIN LINK FENCE
- (M) MEASURED ON THIS SURVEY

