CORNER RECORD

Agency Index **Document Number** County of _____ San Joaquin City of Parcel "B" Per P.M. 4-13, S.J.C.R. Brief Legal Description **CORNER TYPE COORDINATES (Optional)** Government Corner Control Elevation Metric \square U.S. Survey Foot Meander Property Units Other Rancho Horizontal Datum Zone Epoch Date Date of Survey June 9, 2020 Vertical Datum & July 23, 2020 Complies with Public Resources Code §§8801-8819 Sec. 17, T.3S., R.6E., Complies with Public Resources Code §§8890-8902 M.D.B. & M. PLS Act Ref.: 8765(d) 8771 8773 Other:

Established

Reestablished

Rebuilt

Referenced

Narrative of corner identified and monument as found, set, reset, replaced, or removed: ✓ See sheet #2 for description(s):

Left as found

Found and tagged

SURVEYOR'S STATEMENT

This Corner Record was prepared by me or under my direction in conformance with

the Professional Land Surveyors' Act on

P.L.S. or R.C.E. No. L.S. 4450

COUNTY SURVEYOR'S STATEMENT

This Corner Record was received

and examined and filed

February 6, 2024
February 26, 2024
EBat P.L.S. OFR.C.E. No. 8657 Signed

Title


County Surveyor's Comment



Pre-Construction

Post-Construction

Corner/ Monument:

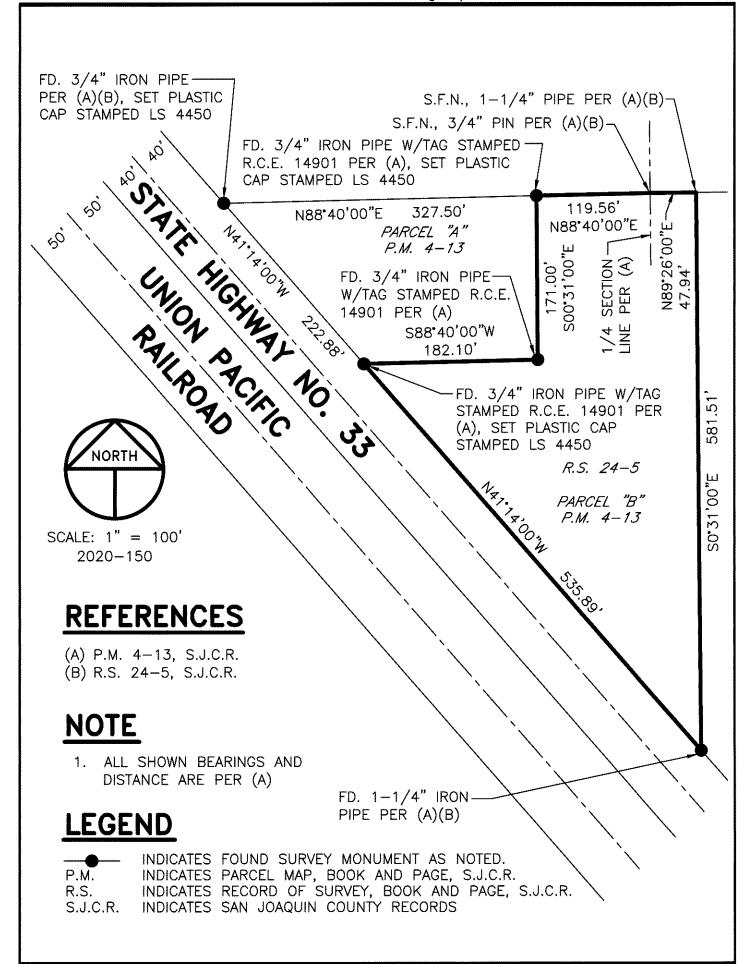

8PELSG-2016 PAGE 2 OF 2