COR	NER	REC	ORD		y Index		28
City of			,		nent Numbei v of SAN	r N JOAQUIN	California
Brief Legal	<b>Descriptio</b> OLF COURSE	<b>n</b> Found cut		walk as sh	own on that	certain map enti d Plats, at Page	tled "TRACT
	<b>-</b>		CORNER T	YPE	N	COORDINATES	3 (Optional )
		Government Meander Rancho Date of Surve		perty [xer	Elevation _ Units Horizontal Dat Zone _ Vertical Datum	Metric U.stumEpoch Date _	S. Survey Foot 🗵
SECTION 21,	T.1N., R.6E.,	M.D.B.&M.				Public Resources C	
PLS Act Ref:	☐ 8765(d	) X	8771	□ 877	3	☐ Other	:
Corner/ Monument:	X Left as a found a		Established Reestablished	☐ Reb 図 Ref	ouilt erenced		onstruction Construction
	REFERENC		OUND PER 31 S ACT 8771				
	S	URVEYOR'S	STATEMENT		,	JSET	LANDSURV
This Corner Record was prepared by me or under my direction in conformance with							
the Profession Signed	Vulen &		P.L.S.		6148	Exp du	. 3-31-2024 No. 6148
			OR'S STATEM				
This Corner Ro			bruary 8,	2024		(3)X	5 E. A. Segil
			1, 2024 P.L.S. 0	<del>or R.C.E</del> . No	8657		ICENSE R
Title	ounty S	surveyor	P.L.S. 6			SPIEO	o. 8657
County Survey	yor's Commei	nt					


## STATEMENT OF PURPOSE:

THE PURPOSE OF THIS SURVEY IS TO IDENTIFY AND RECORD THE LOCATION OF EXISTING MONUMENTS PRIOR TO THE CONSTRUCTION OF PG&E FACILITIES AROUND THE MONUMENTS. THE PURPOSE OF THIS SURVEY IS NOT TO MAKE PROPERTY LINE DETERMINATION. LOT LINES SHOWN HEREON ARE FOR GENERAL LOCATION AND INFORMATIONAL PURPOSES ONLY.

## **DATUM STATEMENT:**

COORDINATES SHOWN HEREON ARE GRID AND ARE BASED ON CITY OF STOCKTON MONUMENTS 30 AND 1008, CALIFORNIA COORDINATE SYSTEM(CCS83). ZONE III, 1983 NAD, AND SHOWN ON RECORD OF SURVEY BOOK 35 OF SURVEYS, PAGE 5. THE PROJECT SPECIFIC COMBINED SCALE FACTOR IS 0.99993803.

## **LEGEND**

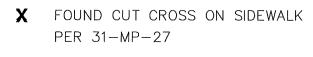

STREET ADDRESS

GRID	COORDINATES (U.S. FEET)			
POINT #	NORTHING	EASTING		
30004	2,160,318.080	6,325,163.456		

