

CORNER RECORD

Agency Index CR-24-129


Document Number _____

City of _____ County of SAN JOAQUIN, California

Brief Legal Description FOUND 2.5" BRASS DISK IN WELL AT THE INTERSECTION OF MACARTHUR DRIVE AND LINNE ROAD

CORNER TYPE

COORDINATES (Optional)

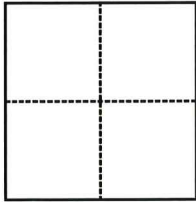

- Government Corner
- Meander
- Rancho
- Control
- Property
- Other

N. _____ E. _____

Elevation _____

Units Metric U.S. Survey Foot

Horizontal Datum _____

Zone _____ Epoch Date _____

Vertical Datum _____

Complies with Public Resources Code §§8801-8819

Complies with Public Resources Code §§8890-8902

PLS Act Ref.: 8765(d) 8771 8773 Other:

Corner/Monument: Left as found Established Rebuilt Pre-Construction
 Found and tagged Reestablished Referenced Post-Construction

Narrative of corner identified and monument as found, set, reset, replaced, or removed:

See sheet #2 for description(s):

FOUND 2.5" BRASS DISK STAMPED LS 6314 IN CONCRETE, IN MONUMENT WELL, AT THE INTERSECTION OF MACARTHUR DRIVE AND LINNE ROAD. AS SHOWN ON CORNER RECORD 14-068.

THIS MONUMENT HAS BEEN REFERENCED PRIOR TO CONSTRUCTION. THE TIES SHOWN HEREON ARE FOR THE PURPOSE OF PERPETUATING FOUND MONUMENTS AND NO CLAIM IS MADE TO THEIR RELATIONSHIP TO THE BOUNDARY LOCATION SHOWN HEREON.

SURVEYOR'S STATEMENT

This Corner Record was prepared by me or under my direction in conformance with

the Professional Land Surveyors' Act on DECEMBER 13, 2023

Signed Nathaniel S. Anderson (P.L.S.) or R.C.E. No. 9667



COUNTY SURVEYOR'S STATEMENT

This Corner Record was received February 28, 2024


and examined and filed March 5, 2024

Signed James E. Hart P.L.S. or R.C.E. No. 8657

Title SAN JOAQUIN COUNTY SURVEYOR



County Surveyor's Comment

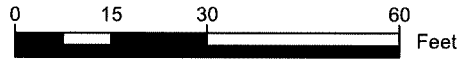

SCALE 1" = 30'

LEGEND

- MONUMENT TIE LINE
- FOUND 2.5" BRASS DISK STAMPED LS 6314, IN CONCRETE IN MONUMENT WELL, PER CORNER RECORD 14-068
- ⊙ FOUND NAIL & SHINER IN THE BASE OF POWER POLES
- ||||| UNION PACIFIC RAILROAD
- (XX.XX') RECORD INFORMATION PER CR-14-068, SAN JOAQUIN COUNTY SURVEYOR'S RECORDS

