

CORNER RECORD

Agency Index CR-24-133


Document Number _____

City of STOCKTON County of SAN JOAQUIN, California

Brief Legal Description FOUND 3/4" IRON PIN TAGGED "R.C.E. 15831" IN MONUMENT WELL, IN SANDALWOOD DRIVE, NEAR AYLESFORD LANE.

CORNER TYPE

COORDINATES (Optional)

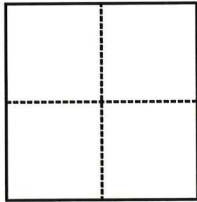

- Government Corner
- Meander
- Rancho
- Control
- Property
- Other

Date of Survey NOVEMBER 9, 2023

N. _____ E. _____

Elevation _____

Units Metric U.S. Survey Foot

Horizontal Datum _____

Zone _____ Epoch Date _____

Vertical Datum _____

Complies with Public Resources Code §§8801-8819

Complies with Public Resources Code §§8890-8902

PLS Act Ref.: 8765(d) 8771 8773 Other:

Corner/
Monument: Left as found Established Rebuilt Pre-Construction

Found and tagged Reestablished Referenced Post-Construction

Narrative of corner identified and monument as found, set, reset, replaced, or removed:

See sheet #2 for description(s):

FOUND 3/4" IRON PIN TAGGED "R.C.E. 15831" IN MONUMENT WELL, IN SANDALWOOD DR, NEAR AYLESFORD LANE, AS SHOWN ON TRACT NO. 1396, "FOX CREEK UNIT NO. 4", MAPS AND PLATS VOL 23 PAGE 71, SAN JOAQUIN COUNTY RECORDS.

THIS MONUMENT HAS BEEN REFERENCED PRIOR TO CONSTRUCTION. THE TIES SHOWN HEREON ARE FOR THE PURPOSE OF PERPETUATING FOUND MONUMENTS AND NO CLAIM IS MADE TO THEIR RELATIONSHIP TO THE BOUNDARY LOCATION SHOWN HEREON.

SURVEYOR'S STATEMENT

This Corner Record was prepared by me or under my direction in conformance with

the Professional Land Surveyors' Act on DECEMBER 15, 2023

Signed Nathaniel S. Anderson P.L.S. or R.C.E. No. 9667



COUNTY SURVEYOR'S STATEMENT

This Corner Record was received February 28, 2024

and examined and filed March 5, 2024

Signed James E. Hart P.L.S. or R.C.E. No. 8657

Title SAN JOAQUIN COUNTY SURVEYOR




County Surveyor's Comment



23-00033-042

LEGEND

- APPROXIMATE LOT LINE
- - - MONUMENT TIE LINE
- FOUND 3/4" IRON PIN TAGGED "R.C.E. 15831" IN MONUMENT WELL, AS SHOWN ON TRACT NO. 1396, "FOX CREEK UNIT NO. 4", MAPS AND PLATS VOL 23 PAGE 71, SAN JOAQUIN COUNTY RECORDS
- SET RIVET & BRASS TAG "REF PT LS 9667" IN CONCRETE CURB
- M&P MAPS AND PLATS, SAN JOAQUIN COUNTY RECORDS
- APN ASSESSOR'S PARCEL NUMBER

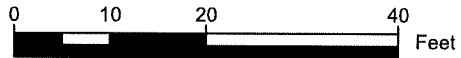

SCALE 1" = 20'

