CORI	VER	CORD			Agency Index Document Numbe			CR-24-142			
									10401111		, California
City of	nown on that	certain	map entitled	TRACT	onun NO.	nent we 1240, /	lls and	d 3/4	l" iron pin	s acce	pted as
CORNER TYP						N		COORDINATES (Optional)			
		Meander Rancho	ent Corner ☐ ☐ ☐ ☐ ☐ ☐ ☐ ☐ ☐ ☐ ☐ ☐ ☐ ☐ ☐ ☐ ☐ ☐ ☐	Contro Prope Other /29/2023	rty	□ Eld □ Ur □ Ho Zo Ve	evation nits orizonta one ertical D	 Il Datul Datum _	Metric mEpoch I	U.S. Date	Survey Foot
SECTION 48 O	F THE C.M. \	VEBER GI	RANT			Со	mplies	with P	ublic Resou	ces Cod	e §§8890-8902
PLS Act Ref:	☐ 8765(d)		☒ 8771			8773				Other:	
Corner/ Monument:	Left as fo □ Found an		☐ Establis ☐ Reestab			Rebuilt Referer					nstruction enstruction
REFERENCEI MONUMENT	REFERENCE	D PER		8771 SI				MP-2		E. CAR	
This Corner Re					on in	conform	iance v	vith	11 1	xp. 3/3	1
the Professiona	Land Survey	The state of							Six	No. 6	
This Corner Real and examined Signed Title County Survey	ecord was rece and filed wes Z / unty Sur	March March Haut reyor	5, 20	-y 26, >24 P.L.S. or	R.C.	E. No	865	7_	* PROF	SIGNAL LICE NO.	E. ALIFORNIA
	o, o common										

STATEMENT OF PURPOSE:

THE PURPOSE OF THIS SURVEY IS TO IDENTIFY AND RECORD THE LOCATION OF EXISTING MONUMENTS PRIOR TO THE CONSTRUCTION OF PG&E FACILITIES AROUND THE MONUMENTS. THIS SURVEY DOES NOT ATTEMPT TO MAKE ANY PROPERTY LINE DETERMINATIONS. LOT LINES SHOWN HEREON ARE FOR GENERAL LOCATION AND INFORMATIONAL PURPOSES ONLY.


LEGEND

- ▼ FOUND 3/4" IRON PIN NO TAG, ACCEPTED

 AS CORNER PER 26-MP-25
- FOUND 3/4" IRON PIN IN MONUMENT BOX PER 26-MP-25

STREET ADDRESS.

MP MAPS AND PLATS

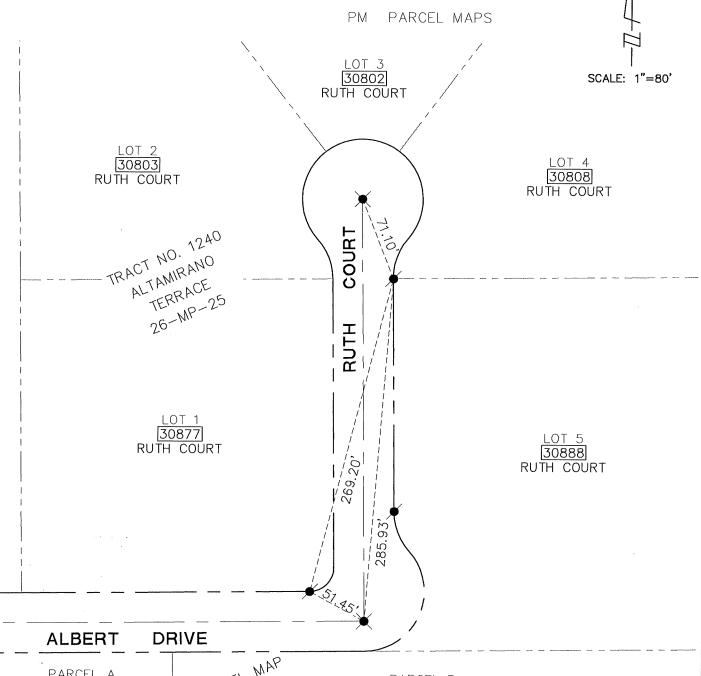

PARCEL A
[31002]
SOUTH AHERN
ROAD

PARCEL MAP 2-PM-64

PARCEL B
31022
SOUTH AHERN
ROAD

Plotted: Feb/16/2024 3:54 PM | By: Lester.carter
DWG: P:\6PGE011202 Misc. Survey Support\SURVEY\Tosk 1383 - PM35449000 30806 Ruth Ct, Tracy\CIVIL3D\V-CORNER RECORD - Ruth Ct - Task 1383.dwg