
CORNER RECORD

Document Number Stockton County of San Joaquin , California Brief Legal Description The north line of the Parcel, shown in Book 35 of Record of Surveys, Page 87 **CORNER TYPE COORDINATES (Optional)** N. E. Government Corner Control Elevation X U.S. Survey Foot Units Meander Property Metric Rancho Other **NAD 83** Horizontal Datum 1991.35 Zone Epoch Date Date of Survey January 11, 2024 Vertical Datum ✓ Complies with Public Resources Code §§8801-8819 Complies with Public Resources Code §§8890-8902 PLS Act Ref.: 8765(d) 8771 8773 X Other: Left as found Established Rebuilt Pre-Construction Corner/ Monument: Found and tagged Reestablished Referenced Post-Construction Narrative of corner identified and monument as found, set, reset, replaced, or removed: ✓ See sheet #2 for description(s): KRIS F. NEHMER SURVEYOR'S STATEMENT No. 8123 This Corner Record was prepared by me or under my direction in conformance with the Professional Land Surveyors' Act on March 25, 2024 8123 Signed P.L.S. or R.C.E. No. **COUNTY SURVEYOR'S STATEMENT** larch 25, 2024 This Corner Record was received and examined and filed Signed

Agency Index CR-24-162

County Surveyor's Comment

Title

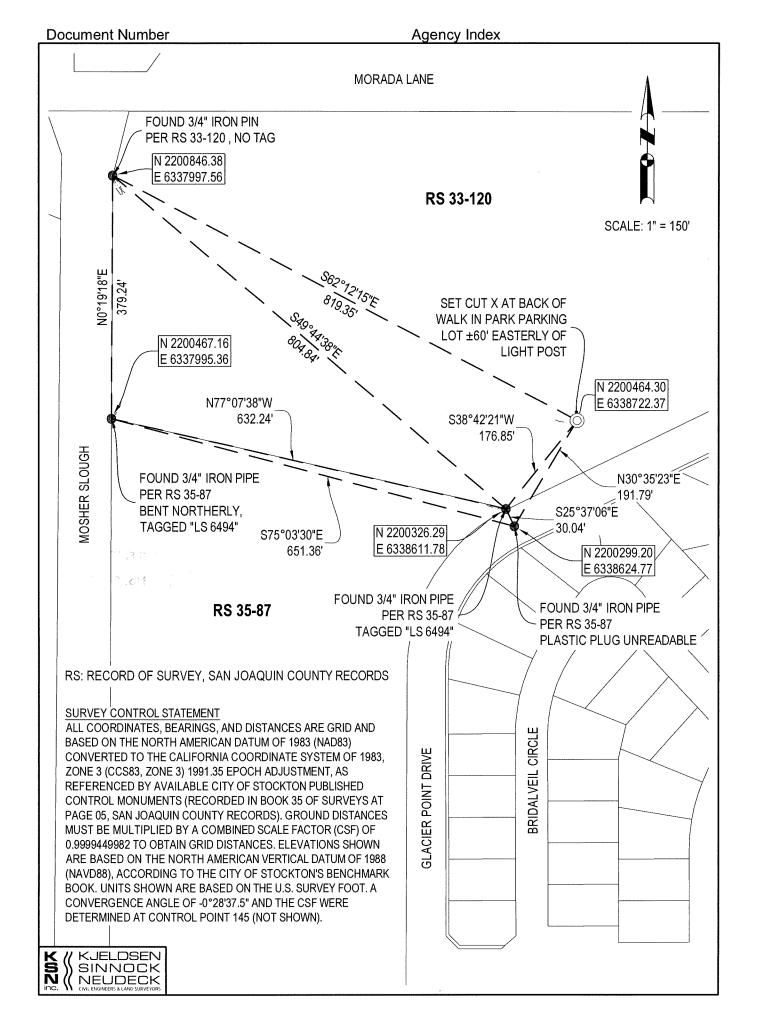

BPELSG-2016 Page 2 of 2