
CR-24-169 **CORNER RECORD** Agency Index **Document Number** LATHROP County of SAN JOAQUIN , California Brief Legal Description 5th STREET, 250' N OF J STREET, N.E. 1/4, SEC. 26, T. 1S., R.6E. M.D.B.& M. **CORNER TYPE COORDINATES (Optional)** Government Corner Control Elevation Meander Property X U.S. Survey Foot Units Metric Rancho Other Horizontal Datum **Epoch Date** Zone Date of Survey January 22, 2024 Vertical Datum Complies with Public Resources Code §§8801-8819 Complies with Public Resources Code §§8890-8902 PLS Act Ref.: 8765(d) X 8771 8773 Other: Left as found Established Rebuilt Pre-Construction Corner/ Monument: Found and tagged Reestablished Referenced Post-Construction Narrative of corner identified and monument as found, set, reset, replaced, or removed: ✓ See sheet #2 for description(s): SURVEYOR'S STATEMENT This Corner Record was prepared by me or under my direction in conformance with the Professional Land Surveyors' Act on January 31, 2024 8159 Signed

COUNTY SURVEYOR'S STATEMENT

This Corner Record was received April 4, 2024
and examined and filed April 22, 2024.
Signed P.L.S. OFR.C.E. No. \$657
Title County Surveyor



County Surveyor's Comment

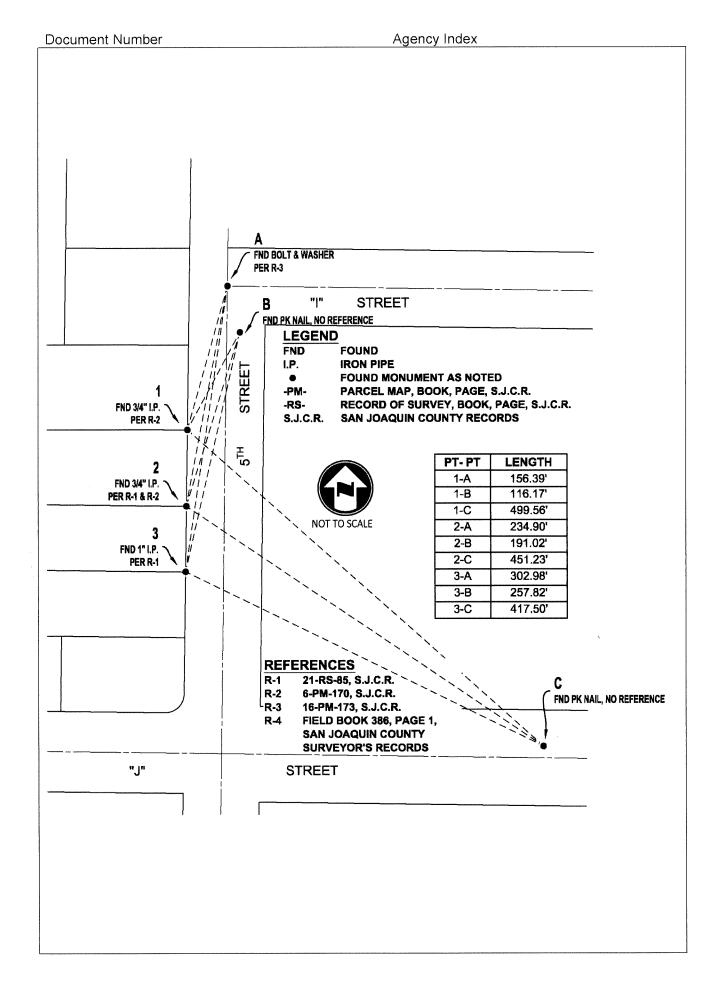

BPELSG-2016 Page 2 of 2