## **CORNER RECORD**

**Document Number** California County of SAN JOAQUIN STOCKTON City of Brief Legal Description FOUND MONUMENTS ALONG SHETLAND COURT, PER M&P 28-90 S.J.C.R. **COORDINATES (Optional) CORNER TYPE** E. N. Government Corner Control Elevation X U.S. Survey Foot X Property Metric Units Meander Other Rancho Horizontal Datum Epoch Date Zone Date of Survey July 12, 2022 Vertical Datum Complies with Public Resources Code §§8801-8819 T2N/R6E Complies with Public Resources Code §§8890-8902 Other: 8773 8771 PLS Act Ref .: × 8765(d) Pre-Construction Rebuilt Established Left as found Corner/ ☐ Post-Construction Monument: Referenced Reestablished Found and tagged Narrative of corner identified and monument as found, set, reset, replaced, or removed: See sheet #2 for description(s): SURVEYOR'S STATEMENT This Corner Record was prepared by me or under my direction in conformance with No. 8489 September 12, 2022 the Professional Land Surveyors' Act on 8489 P.L.S. or R.C.E. No. Signed OF CALIF COUNTY SURVEYOR'S STATEMENT April 2, 2024 This Corner Record was received April 19, 2024.

5 Haut P.L.S. OFR.C.E. No. 8657


Surveyor and examined and filed Signed

CR-24-181

Agency Index

**County Surveyor's Comment** 

Title

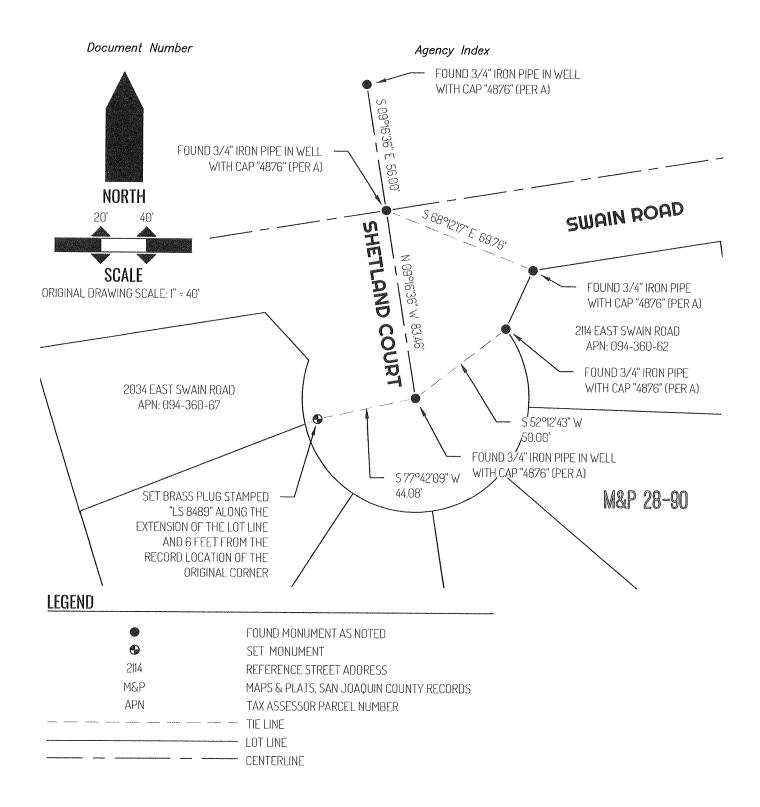

## REFERENCES

(A) BOOK OF MAPS AND PLATS, VOLUME 28, PAGE 90, SAN JOAQUIN COUNTY RECORDS