

CORNER RECORD


Agency Index CR-24-185
Document Number _____

City of _____ County of SAN JOAQUIN, California

Brief Legal Description FOUND REBAR WITH CAP STAMPED RCE 14269 IN WELL IN CENTERLINE OF STONERIDGE DRIVE, APPROXIMATELY 508' SOUTH OF GRANT LINE ROAD.

CORNER TYPE

COORDINATES (Optional)

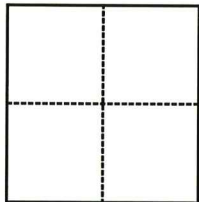

- Government Corner
- Meander
- Rancho
- Control
- Property
- Other

Date of Survey MARCH 13, 2024

N. _____ E. _____
 Elevation _____
 Units Metric U.S. Survey Foot
 Horizontal Datum _____
 Zone _____ Epoch Date _____
 Vertical Datum _____
 Complies with Public Resources Code §§8801-8819
 Complies with Public Resources Code §§8890-8902

- PLS Act Ref.: 8765(d) 8771 8773 Other:
- Corner/Monument: Left as found Established Rebuilt Pre-Construction
 Found and tagged Reestablished Referenced Post-Construction

Narrative of corner identified and monument as found, set, reset, replaced, or removed:

See sheet #2 for description(s):

FOUND REBAR WITH CAP STAMPED RCE 14269 IN MONUMENT WELL IN CENTERLINE OF STONERIDGE DRIVE APPROXIMATELY 508' SOUTH OF GRANT LINE ROAD, AS SHOWN ON MAPS & PLATS 23-052, SAN JOAQUIN COUNTY RECORDS.

THIS MONUMENT HAS BEEN REFERENCED PRIOR TO CONSTRUCTION. THE TIES SHOWN HEREON ARE FOR THE PURPOSE OF PERPETUATING FOUND MONUMENTS AND NO CLAIM IS MADE TO THEIR RELATIONSHIP TO THE BOUNDARY LOCATION SHOWN HEREON.

SURVEYOR'S STATEMENT

This Corner Record was prepared by me or under my direction in conformance with

the Professional Land Surveyors' Act on APRIL 15, 2024

Signed Nathaniel S. Anderson P.L.S. or R.C.E. No. 9667



COUNTY SURVEYOR'S STATEMENT

This Corner Record was received April 16, 2024

and examined and filed April 23, 2024

Signed James E. Hart P.L.S. or R.C.E. No. 8657


Title SAN JOAQUIN COUNTY SURVEYOR



County Surveyor's Comment



23-00033-079

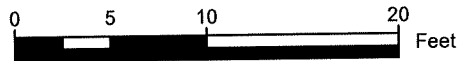

SCALE 1" = 10'

LEGEND

- APPROXIMATE LOT LINE
- - - MONUMENT TIE LINE
- FOUND REBAR WITH CAP STAMPED RCE 14269, IN MONUMENT WELL, IN STONERIDGE DRIVE, APPROXIMATELY 508' SOUTH OF GRANT LINE ROAD. PER (23 M 052)
- SET 3/4" IRON PIPE WITH PLUG AND BRASS TAG "REF PT LS 9667", IN DIRT.
- M MAPS AND PLATS, SAN JOAQUIN COUNTY RECORDS.
- APN ASSESSOR'S PARCEL NUMBER

