
CORNER RECORD

CR-24-204 Document Number SAN JOAQUIN City of STOCKTON County of Brief Legal Description FOUND MONUMENT NEAR THE WESTERLY RIGHT-OF-WAY OF WEST LANE PER BOOK 8 OF PARCEL MAPS, PAGE 112 S.J.C.R. **CORNER TYPE COORDINATES (Optional)** N. E. Elevation Government Corner Control X U.S. Survey Foot X Property Units Metric Meander SEC Other Rancho 28 Horizontal Datum Zone **Epoch Date** Date of Survey June 9, 2022 Vertical Datum Complies with Public Resources Code §§8801-8819 C.M. WEBER GRANT Complies with Public Resources Code §§8890-8902 Other: X 8771 8773 PLS Act Ref.: 8765(d) X Pre-Construction Left as found Established Rebuilt Corner/ Monument: Reestablished Post-Construction Found and tagged Referenced Narrative of corner identified and monument as found, set, reset, replaced, or removed: See sheet #2 for description(s): THE FOUND MONUMENT(S) SHOWN ON THIS CORNER RECORD WERE FOUND IN THE APPROXIMATE RECORD LOCATION OF THE CORNER(S) ON PM 8-112, SAN JOAQUIN COUNTY RECORDS. I DID NOT VERFIY THE IDENTITY OR VALIDITY OF THE MONUMENT AS ACTUALLY MARKING THE PROPERTY CORNER. SURVEYOR'S STATEMENT This Corner Record was prepared by me or under my direction in conformance with No. 8489 the Professional Land Surveyors' Act on December 29, 2023 8489 P.L.S. or R.C.E. No. Signed COUNTY SURVEYOR'S STATEMENT This Corner Record was received and examined and filed LICENSE Signed NO. 8657 Title **County Surveyor's Comment**

Agency Index

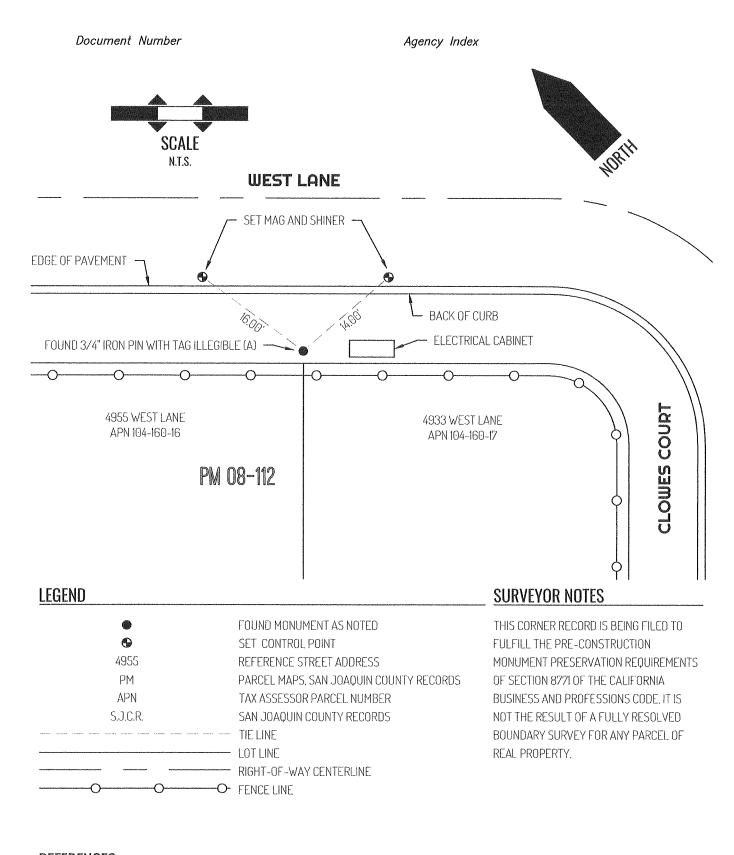

REFERENCES

(A) PARCEL MAP BOOK 8, AT PAGE 112, SAN JOAQUIN COUNTY RECORDS

Page 2 of 2 #043-268